


T. 6 S. R. 1 E. W. M.

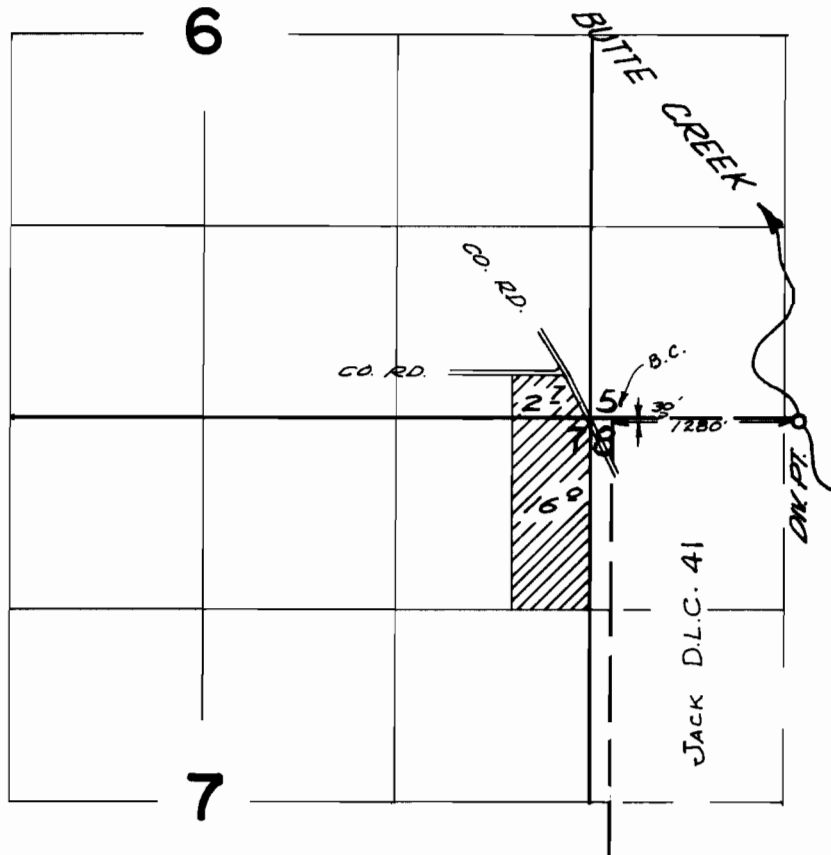

FINAL PROOF SURVEY UNDER

Application No. 37077 Permit No. 27581
IN NAME OF

EARL ROSS

Surveyed Aug 17 1966, by V. GARNER