T.5 S. R.2 W. W.M.

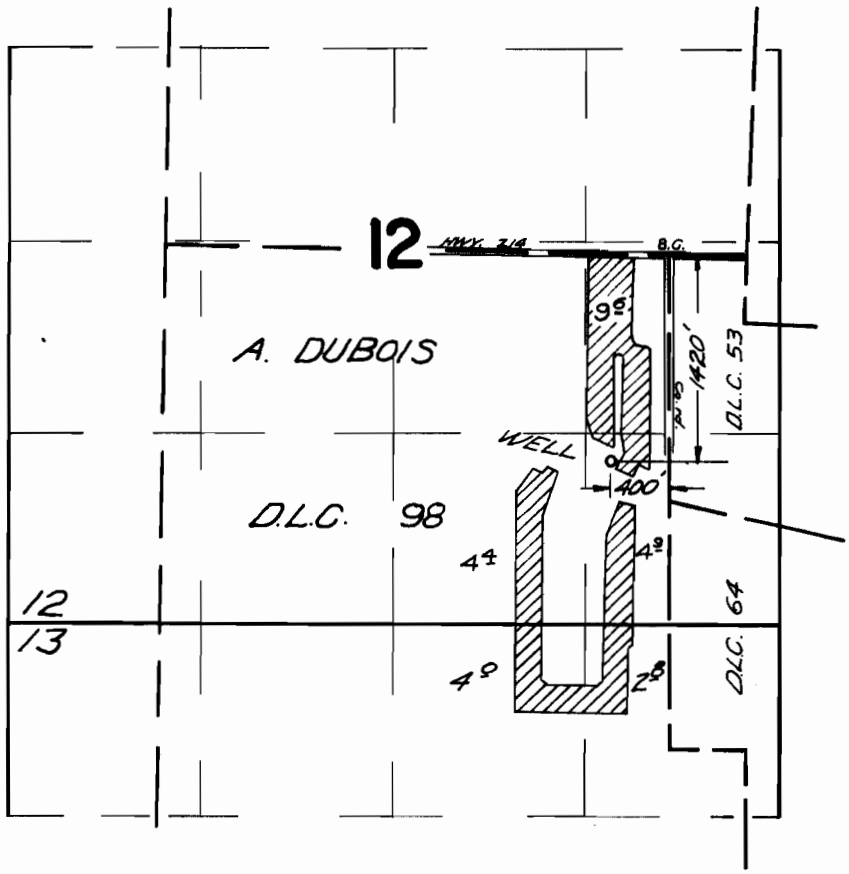

FINAL PROOF SURVEY
UNDER

Application No. G-3269 Permit No. G-3065
IN NAME OF

SENIOR ESTATES INC.

Surveyed Sept. 30 1966, by V. GARNER

1966-D