


# T.6 S. R.3 W. W.M.

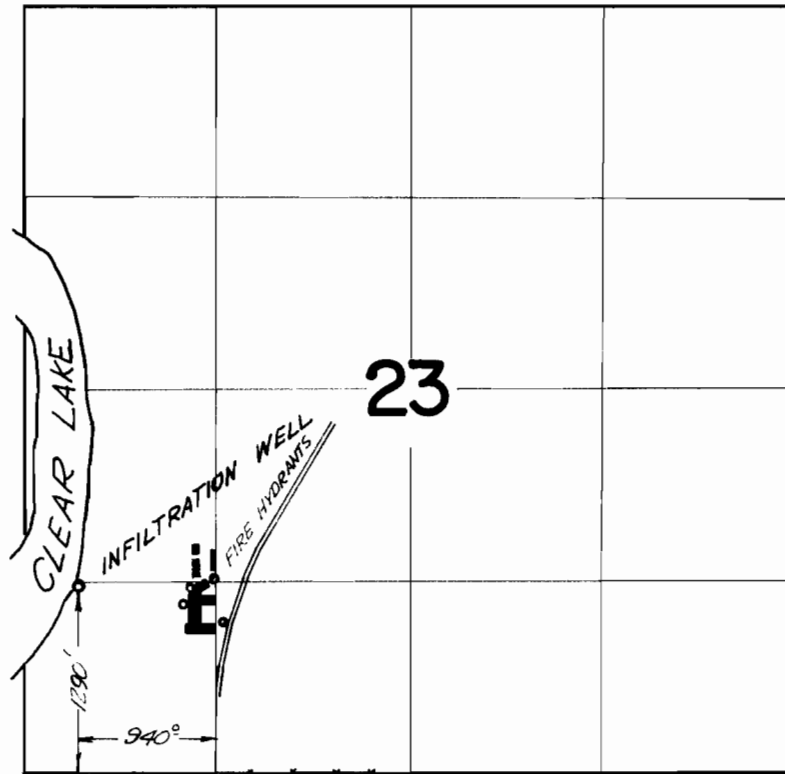

## FINAL PROOF SURVEY UNDER

Application No. 37670 . Permit No. 28077 .  
IN NAME OF

*WILLAMETTE LUTHERAN HOMES, INC.*

Surveyed *Sept 7 1966*, by *V. GARNER*.