


T.4 S. R.2 W. W.M.

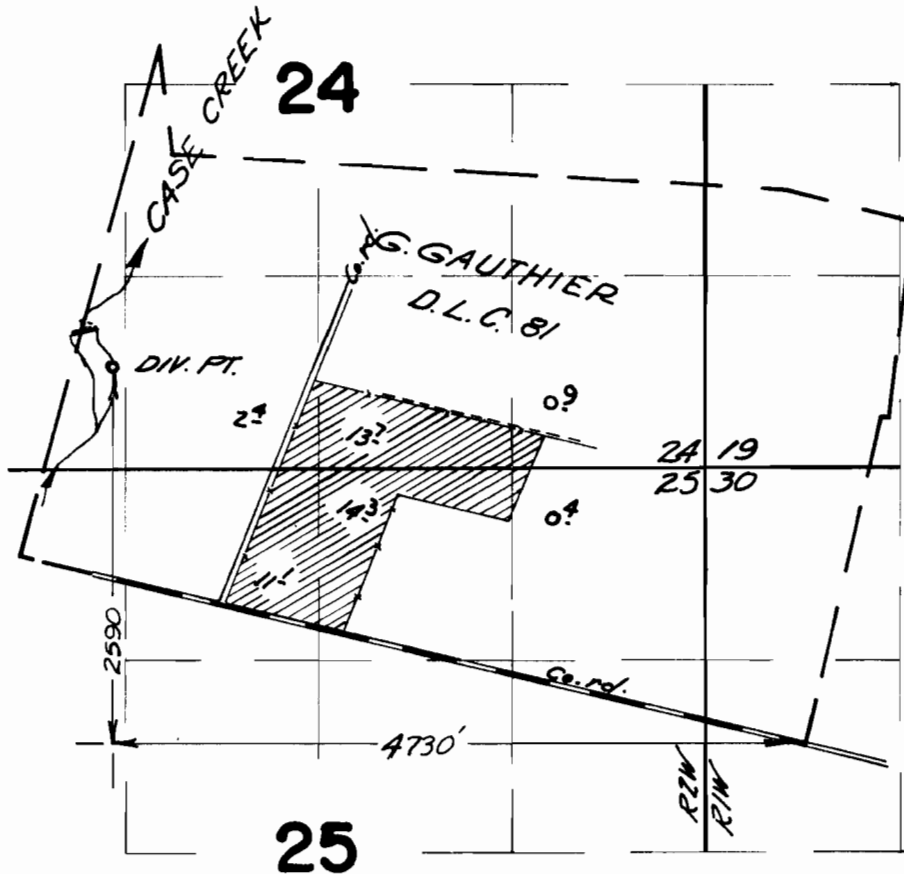

FINAL PROOF SURVEY UNDER

Application No. 37464 Permit No. 27892
IN NAME OF

ROBERT G. WILLIAMSON

Surveyed Oct. 21, 1966, by V. Garner