


# T. 4 N. R. 27 & 28 E. W. M.

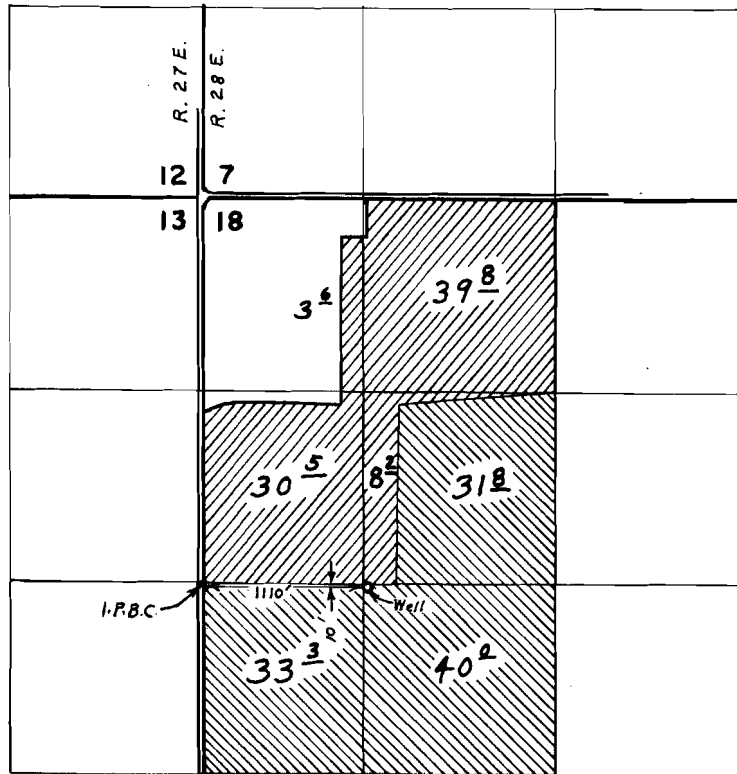

Primary   
 Supplemental 

## FINAL PROOF SURVEY UNDER

Application No. G-2768 Permit No. G-2592

IN NAME OF

**THOMAS E. HUDDLESTON**

Surveyed August 8, 1966, by L. E. Gould