


# T. 4 S. R. 1 E. W. 1 M.

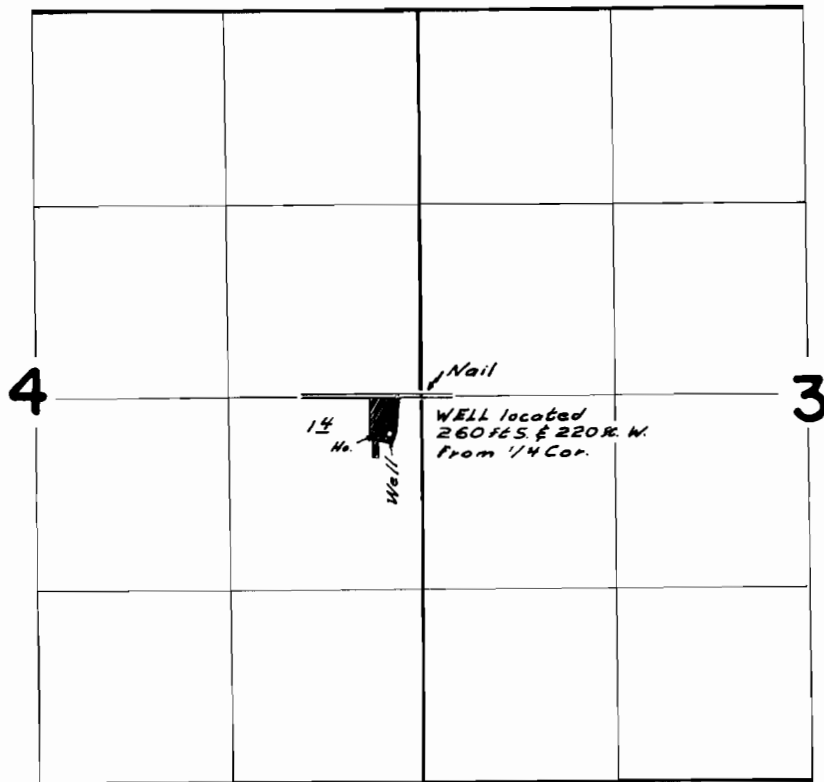

## FINAL PROOF SURVEY UNDER

Application No. G-2583 Permit No. G-2395  
IN NAME OF

*Harvey Tofte*

Surveyed Oct 18, 1966, by W.J. Ruppert