


T.4S.R.1E.W.M.

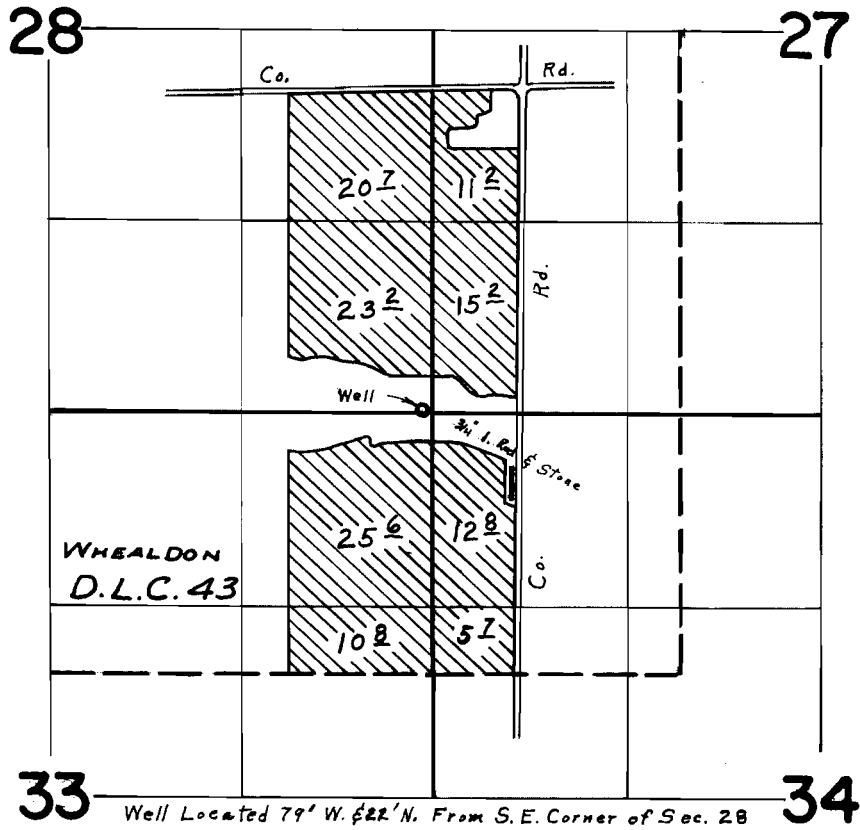

FINAL PROOF SURVEY UNDER

Application No. G-2980. Permit No. G-2776.
IN NAME OF

WILFORD A. NELSON

Surveyed Oct. 20, 1966, by L. E. Gould
Nov. 17, 1967

1967-W
DFK-3D-47