


T.2S. R.6 E. W.M.

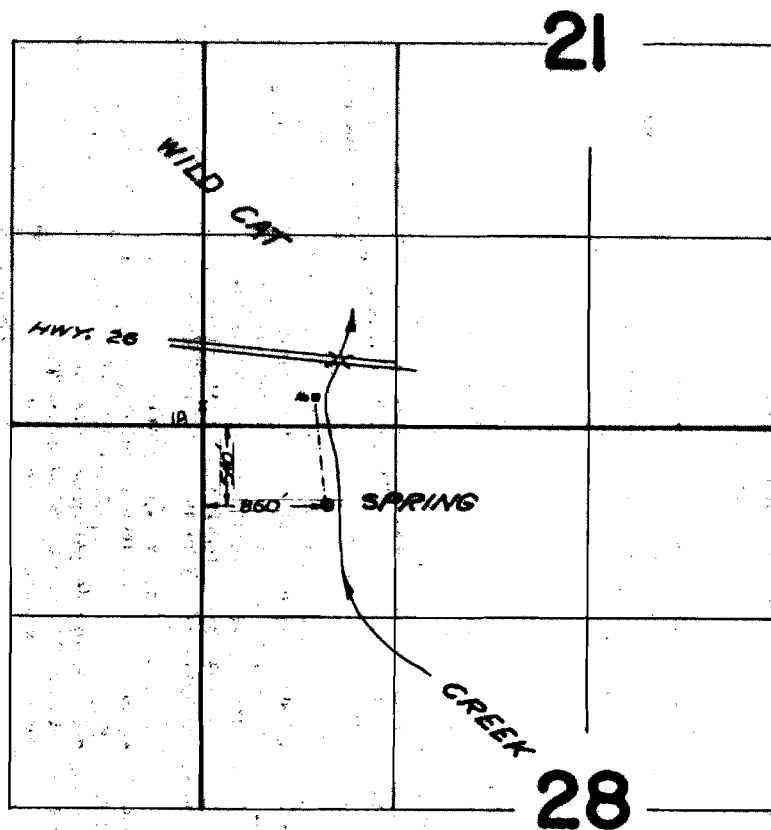

FINAL PROOF SURVEY
UNDER

Application No. 10905 Permit No. 30401
IN NAME OF

J. C. LUNSFORD

Surveyed Aug. 24 1966, by V. GARNER