


T.38S.R.14W.W.M.

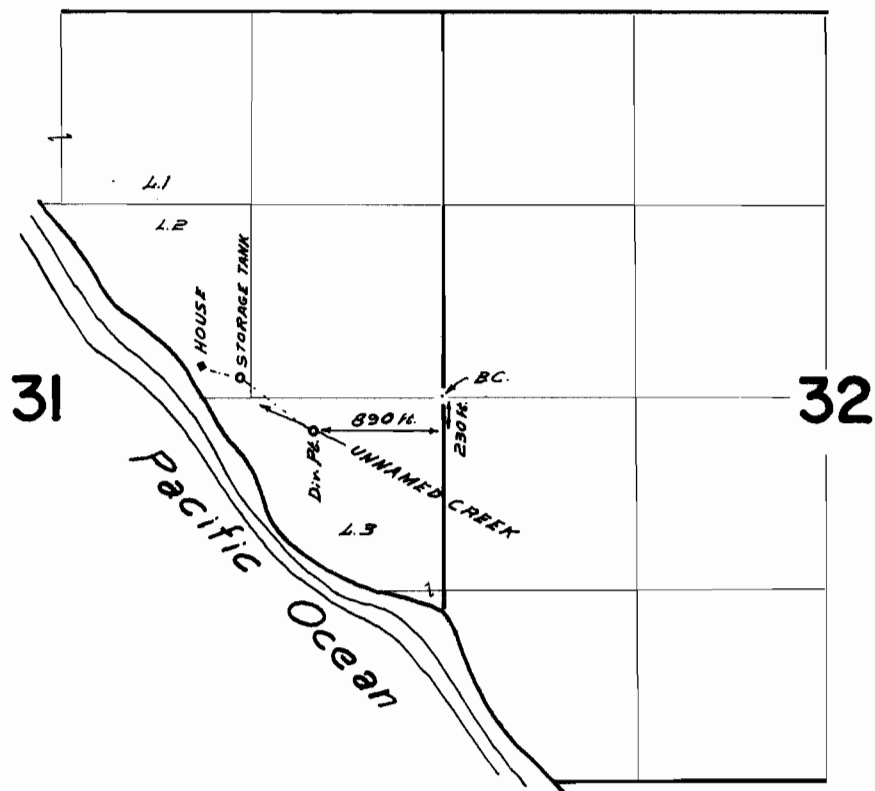

FINAL PROOF SURVEY
UNDER

Application No. 38288 Permit No. 28521
IN NAME OF

Oleta A. Walker

Surveyed Sept. 19 1966, by W.V. Ruppert