


T.21S.R.4W.W.M.

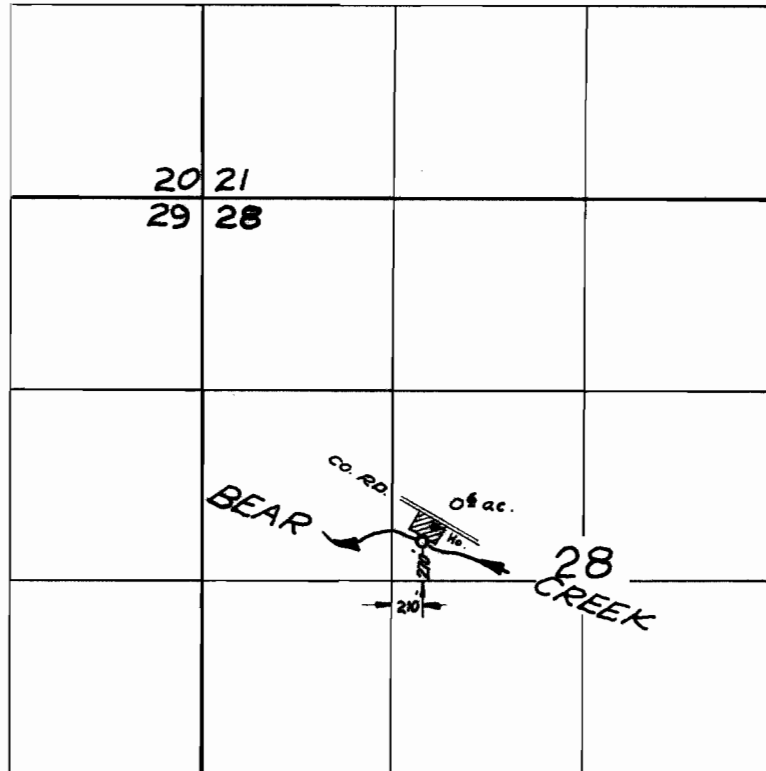

FINAL PROOF SURVEY
UNDER

Application No. 38949 Permit No. 29088
IN NAME OF

OTTO and FLORA GREGORY

Surveyed May 18 1966, by V. GARNER