
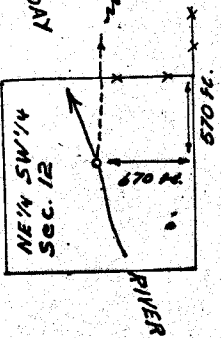


T.13 & 14S. R.34 & 35E. WM.

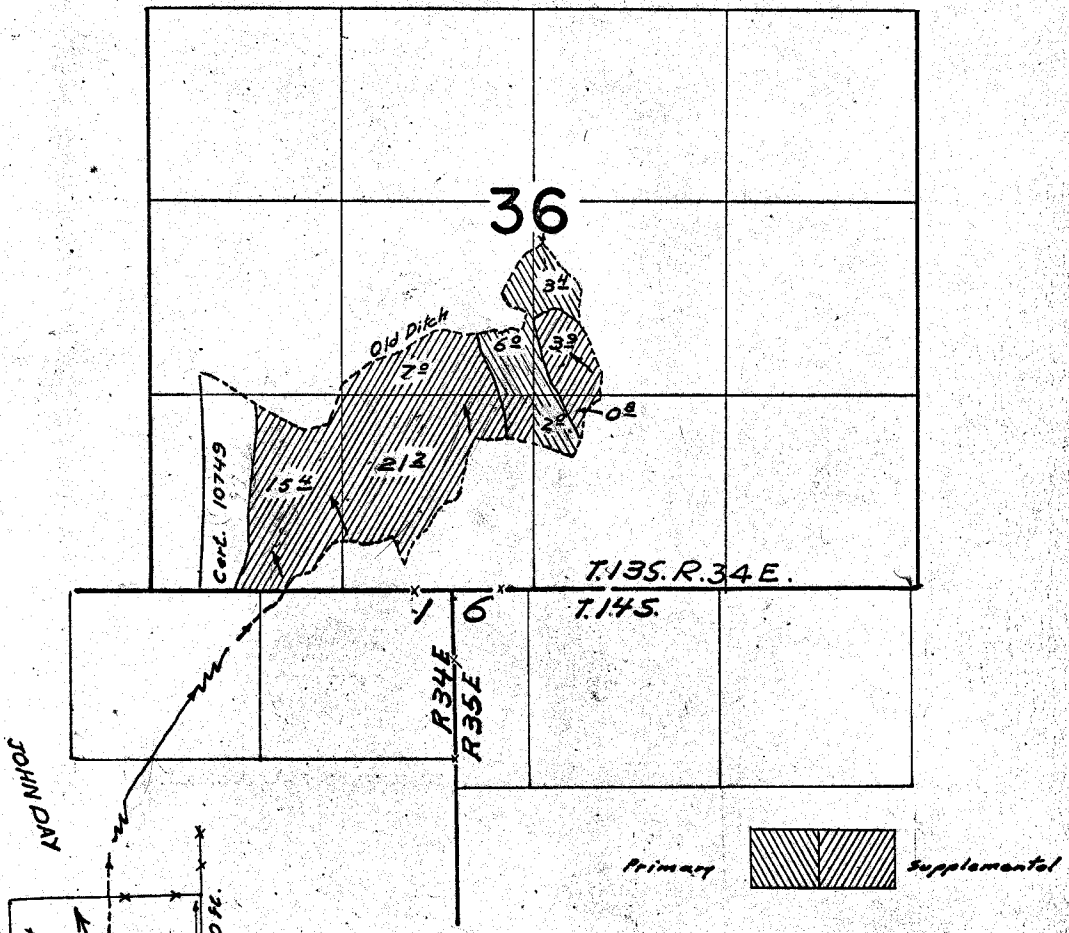

FINAL PROOF SURVEY UNDER

Application No. 37188 Permit No. 27717
IN NAME OF

Herbert T. & Jessie Deardorff

Surveyed July 15, 1956, by W. J. Ruppert