


T.17S. R.29E.W.M.

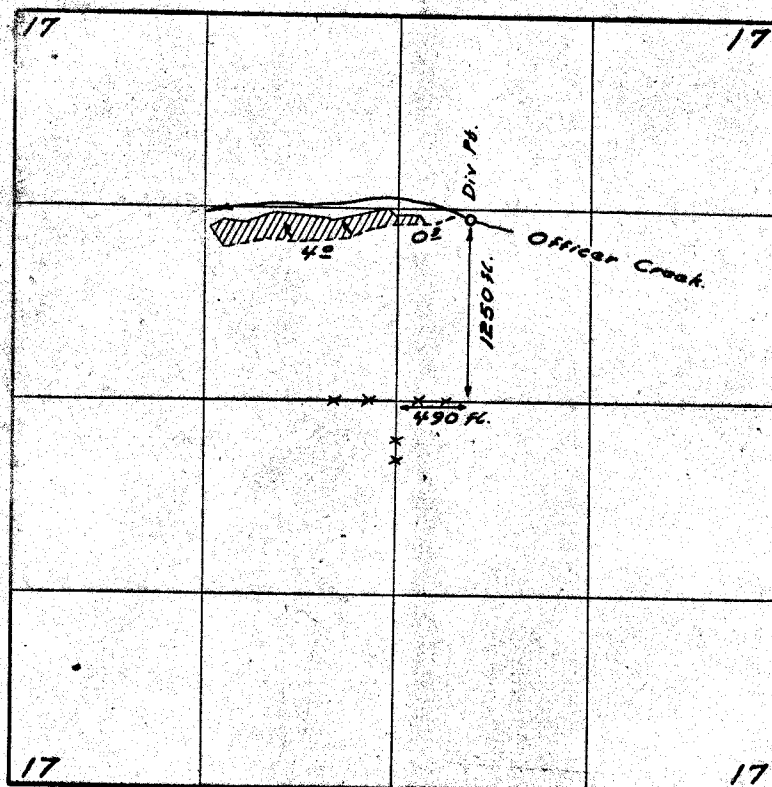

FINAL PROOF SURVEY
UNDER

Application No. 37226 Permit No. 27743
IN NAME OF

Farrell Lemons

Surveyed June 7 1966, by W.J. Ruppert