


34601 P.27742 6
 34603 P.27744
 34604 P.27745

T.17 S. R. 29 E. W.M.

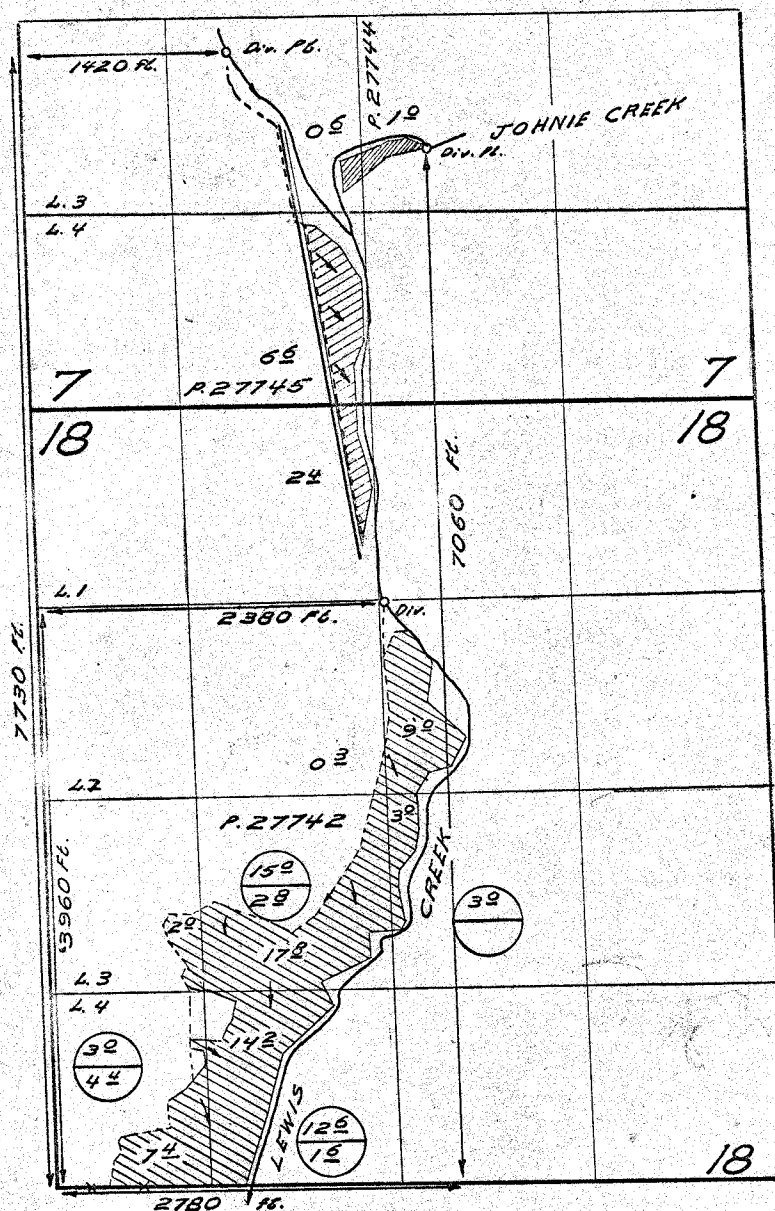

FINAL PROOF SURVEY
 UNDER

PRIOR RIGHTS
 THIS PERMIT

37225 27742
 37227 27744
 Application No. 37228 Permit No. 27745
 IN NAME OF

FARRELL LEMONS

Surveyed June 22 1966, by H. J. Ruppert