


# T 18 S R 1 W W M

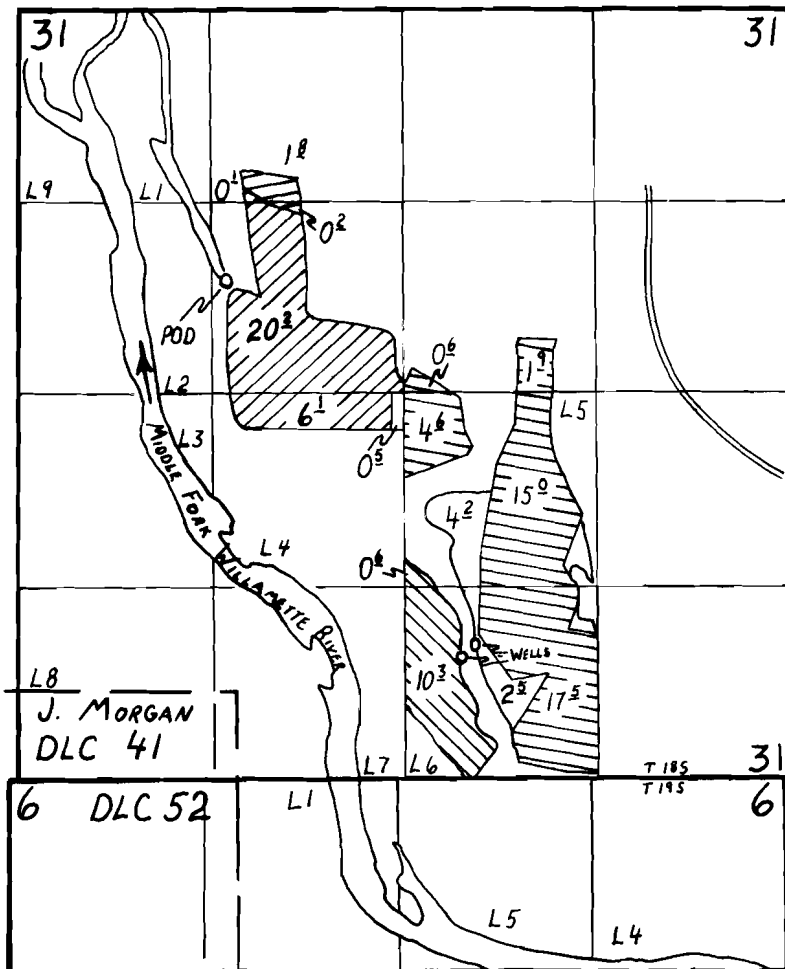

POD IS LOCATED 770' N AND 1200' W; THE WELL FOR PERMIT G-7797 IS LOCATED 1800' S AND 400' E; THE WELL FOR PERMIT G-2414 IS LOCATED 1720' S AND 480' E; ALL BEING LOCATED FROM THE CENTER 1/4 OF SECTION 31

- |   |   |   |   |   |
|---|---|---|---|---|
|  |  |  |  |  |
| IRR. UNDER PERMIT G-2414 AND SUPP. IRR. UNDER PERMIT 48427                          | IRR. UNDER PERMIT G-7797  | SUPP. IRR. TO PERMIT 26502 UNDER PERMIT 48427                                       | IRR. UNDER PERMIT 48427   | OVER ALCREAGE IRR.  |

## FINAL PROOF SURVEY UNDER

Application No. ~~55574~~ <sup>G-2579</sup> <sub>G-7963</sub> Permit No. ~~48427~~ <sup>G-2414</sup> <sub>G-7797</sub>.....  
IN NAME OF

.....GARY A. SANDGATHE.....  
MAY 5 66 V. GARNER  
AUG 3 82 L. M. TOLL  
Surveyed Aug. 8, 1990., by T. M. WARREN.....