


# T.17 S. R.2 W. W.M.

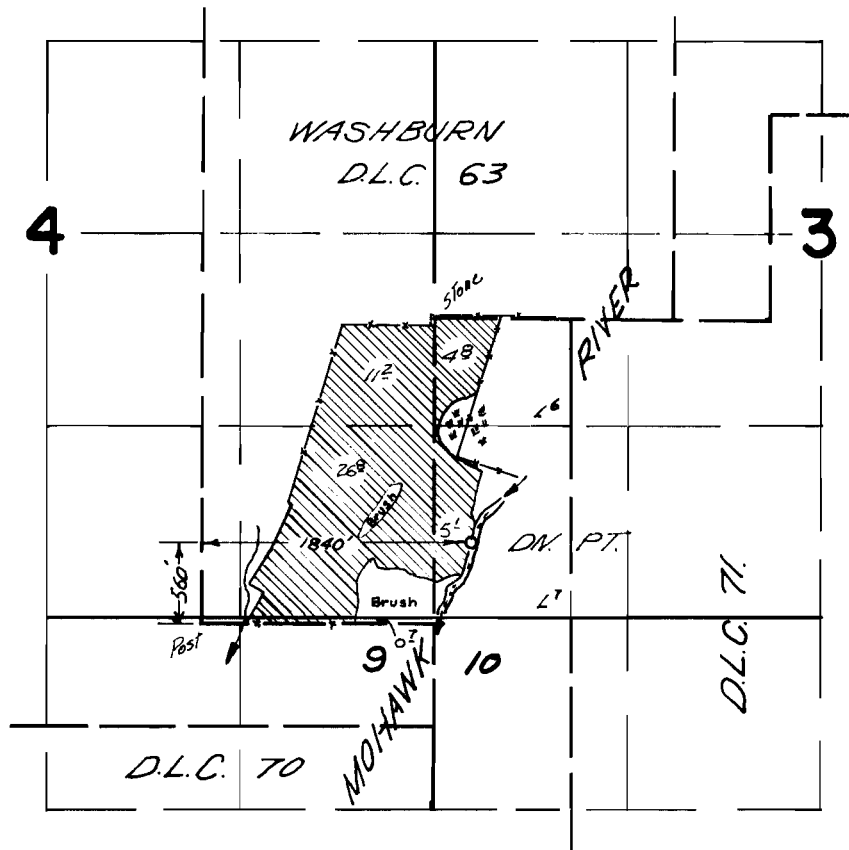

## FINAL PROOF SURVEY UNDER

Application No. 37740 Permit No. 28130  
IN NAME OF

*H. R. STAFFORD*

Surveyed May 11, 1966, by V. GARNER