


T.17 S. R.1&2 W. W.M.

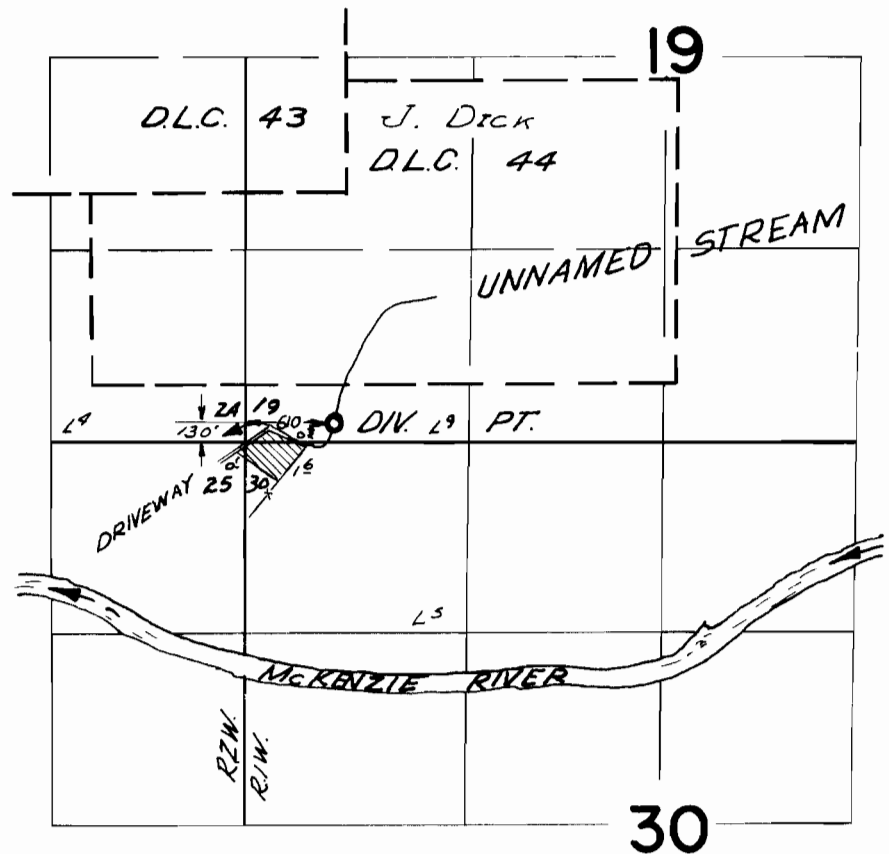

FINAL PROOF SURVEY
UNDER

Application No. 38083 Permit No. 28436
IN NAME OF

E. H. HALL and FRED W. CRABTREE

Surveyed May 6 1966, by V. GARNER