


T.20 & 21 S. R. 2 W. W.M.

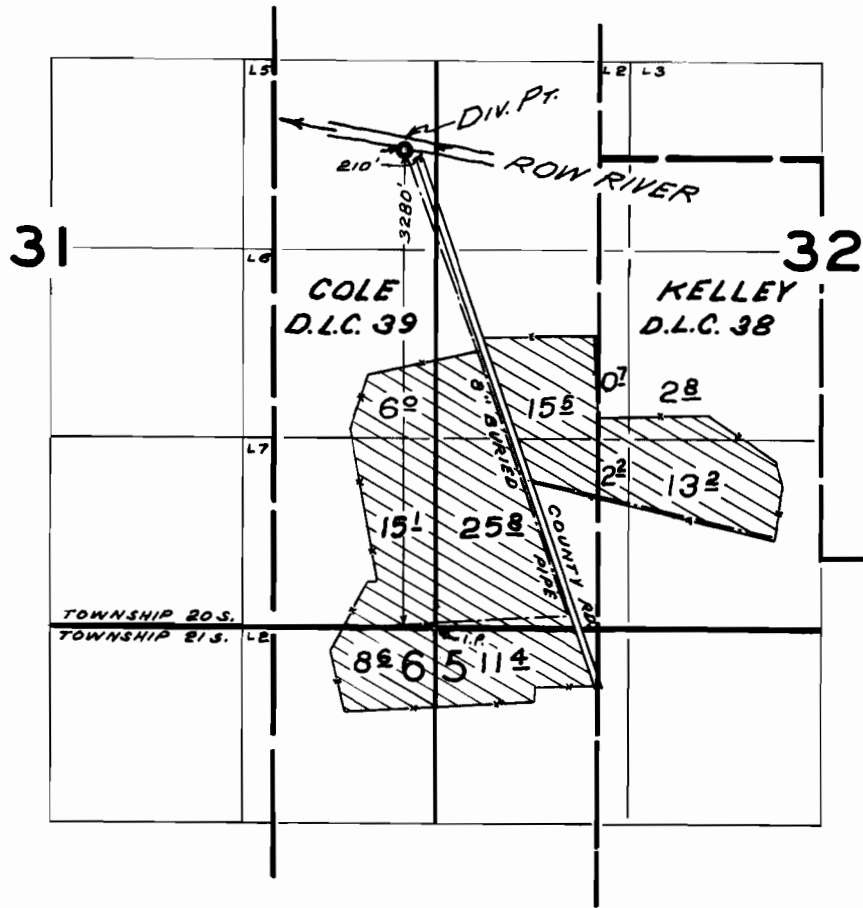

FINAL PROOF SURVEY
UNDER

Application No. 38580 Permit No. 28741
IN NAME OF
UNITED STATES DEPT. OF AGRICULTURE
FOREST SERVICE

Surveyed MAY 10 1966, by L. GOULD