


T.17 S.R.7 W.W.M.

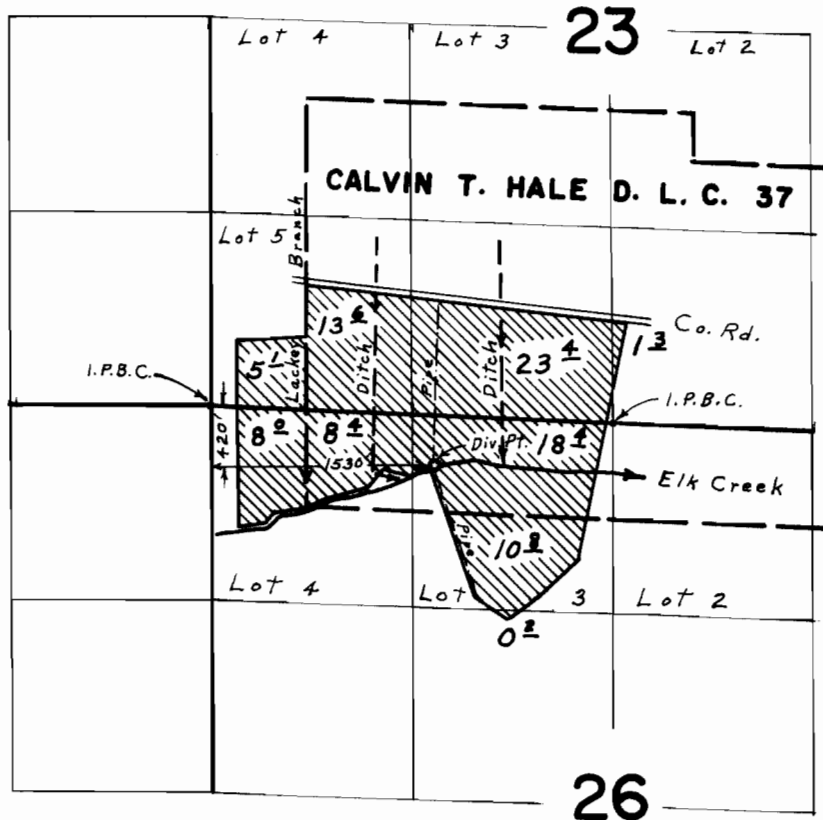

FINAL PROOF SURVEY
UNDER

Application No. 38954 Permit No. 28978
IN NAME OF
HALE BROS LOGGING CO.

Surveyed July 19, 1967, by L. E. Gould