


T.20S.R.2 W.W.M.

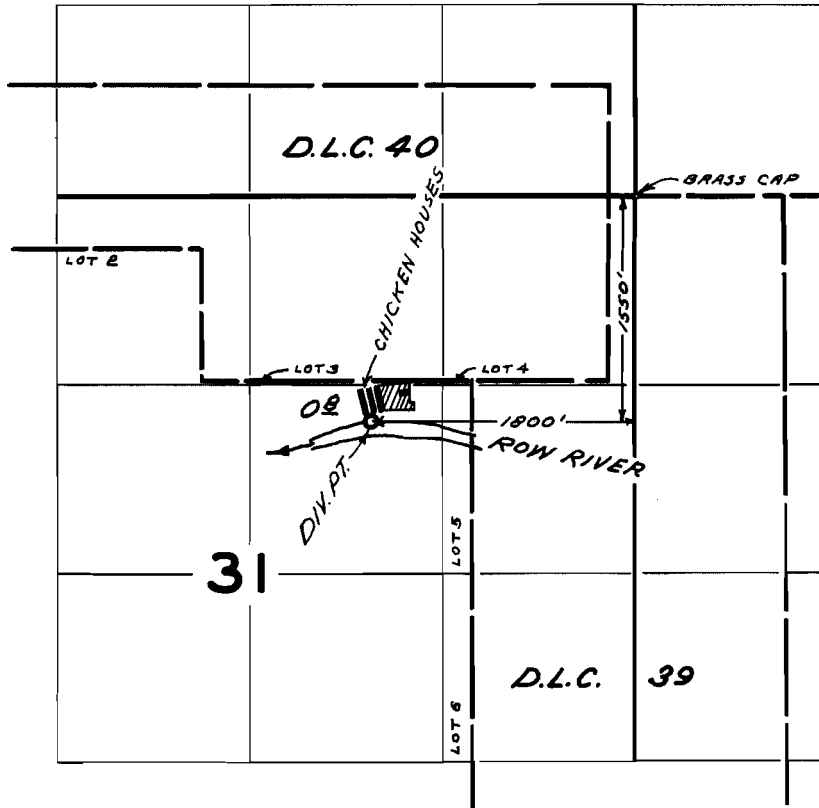

FINAL PROOF SURVEY
UNDER

Application No. 39882 Permit No. 29692
IN NAME OF

ROBERT BAKER BOND

Surveyed MAY 10 1966, by L. GOULD