


T.16 S.R.5 W.W.M.

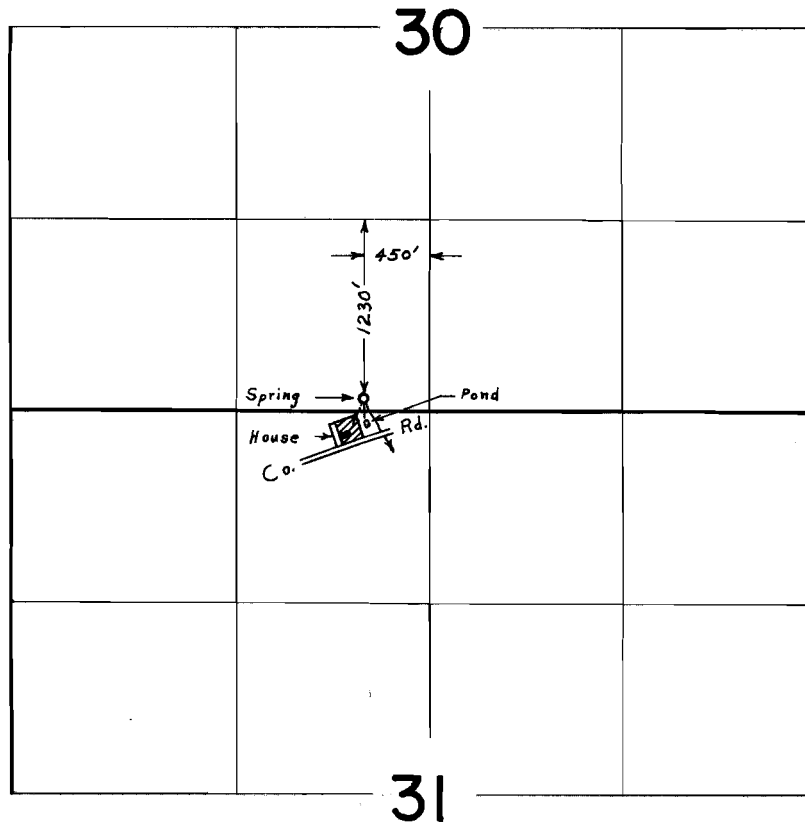

FINAL PROOF SURVEY UNDER

Application No. 40559 Permit No. 30190
IN NAME OF

RICHARD P. BARRETT

Surveyed May 11, 1967, by L. E. Gould