


T.10&11S.R.2W.W.M.

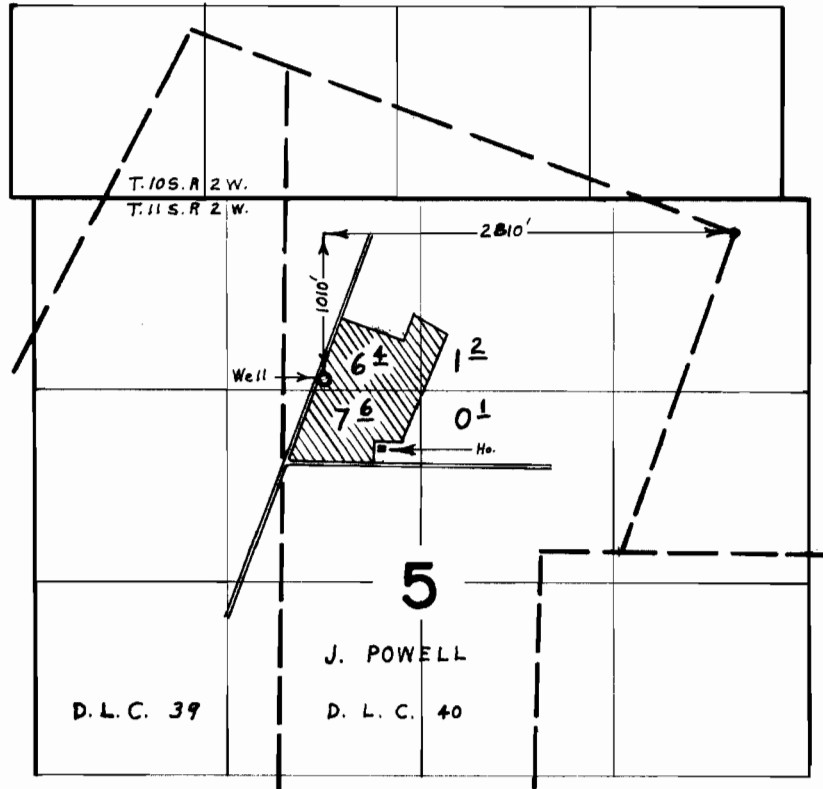

FINAL PROOF SURVEY UNDER

Application No. G-2273 Permit No. G-2085
IN NAME OF

KYLE B. AND MARY FOLSOM

Surveyed May 5, 1966, by L. E. Gould