


T.12S.R.2W.W.M.

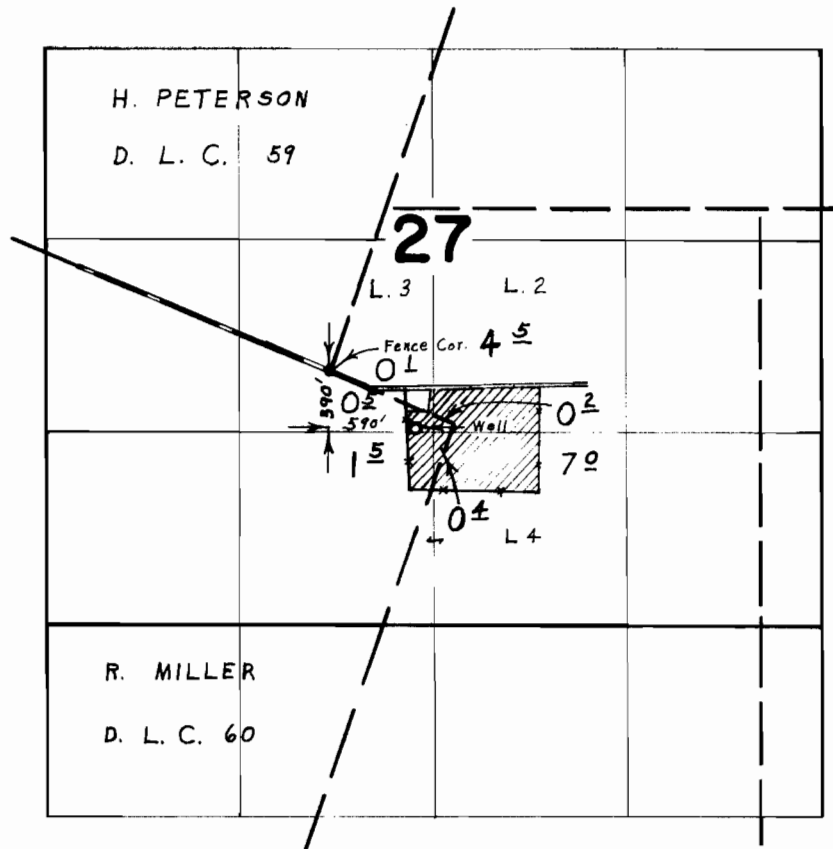

FINAL PROOF SURVEY
UNDER

Application No. G-2497 Permit No. G-2309
IN NAME OF

ROY E. & SELMA KINZER

Surveyed May 6, 1966, by L. E. Gould