


T.16S. R.4W. W.M.

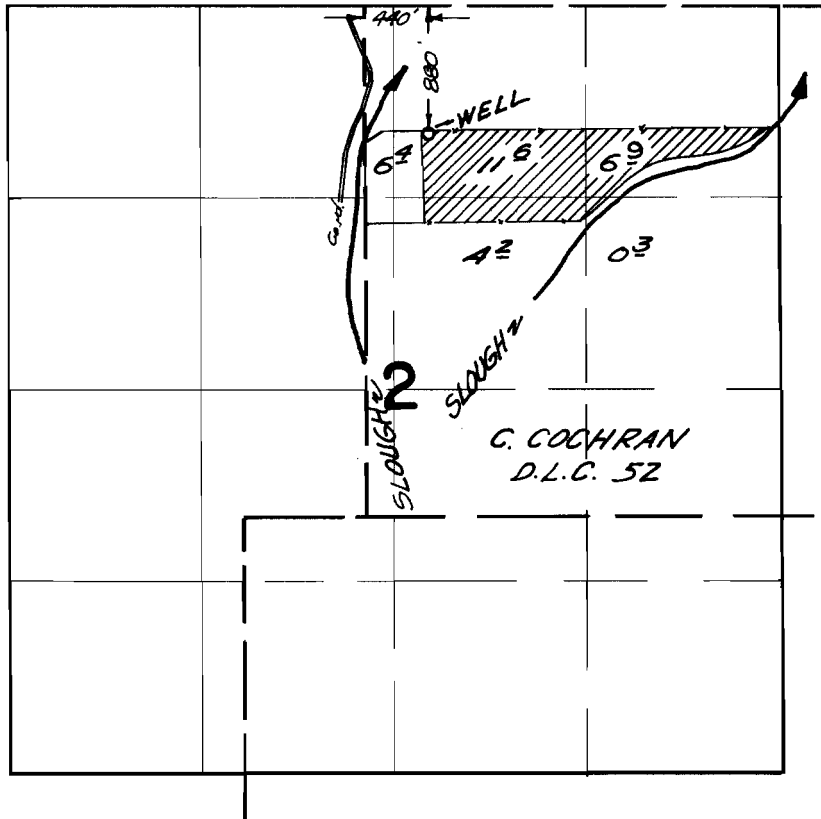

FINAL PROOF SURVEY UNDER

Application No. G-2618 Permit No. G-2129
IN NAME OF

HARLAN L and ADA P. ROSS

Surveyed July 29 1966, by V. GARNER