


T. 30 S. R. 46 E. W. M.

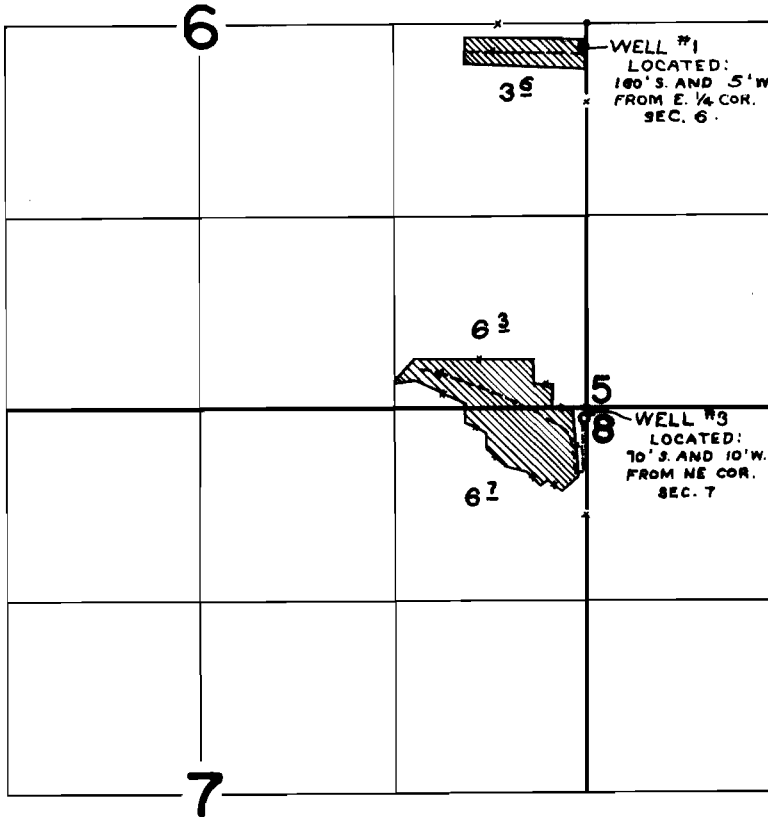

FINAL PROOF SURVEY

UNDER

Application No. G-1805 Permit No. G-2131

IN NAME OF

Cowgill Ranch

Surveyed Oct. 13 1965, by C. GARDNER