


T. 7 S. R. 2 W. W.M.

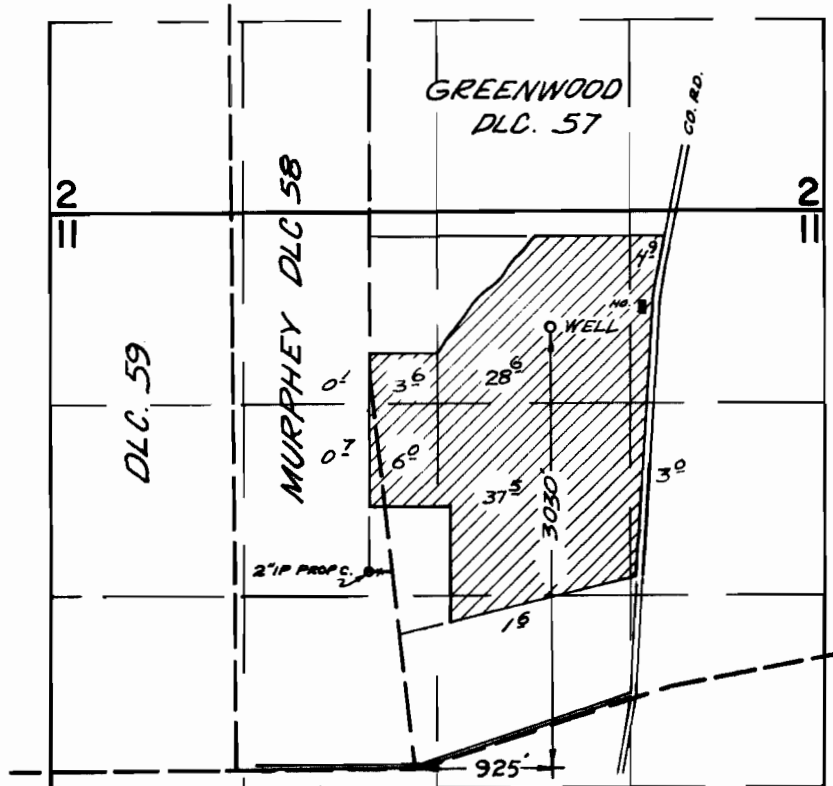

FINAL PROOF SURVEY UNDER

Application No. *G-1758*. Permit No. *G-1670*..
IN NAME OF

DANIEL H. ROSS

Surveyed *Nov. 20*. 1967, by *V. Garner*.....