


# T.6 S. R.3 W.W.M.

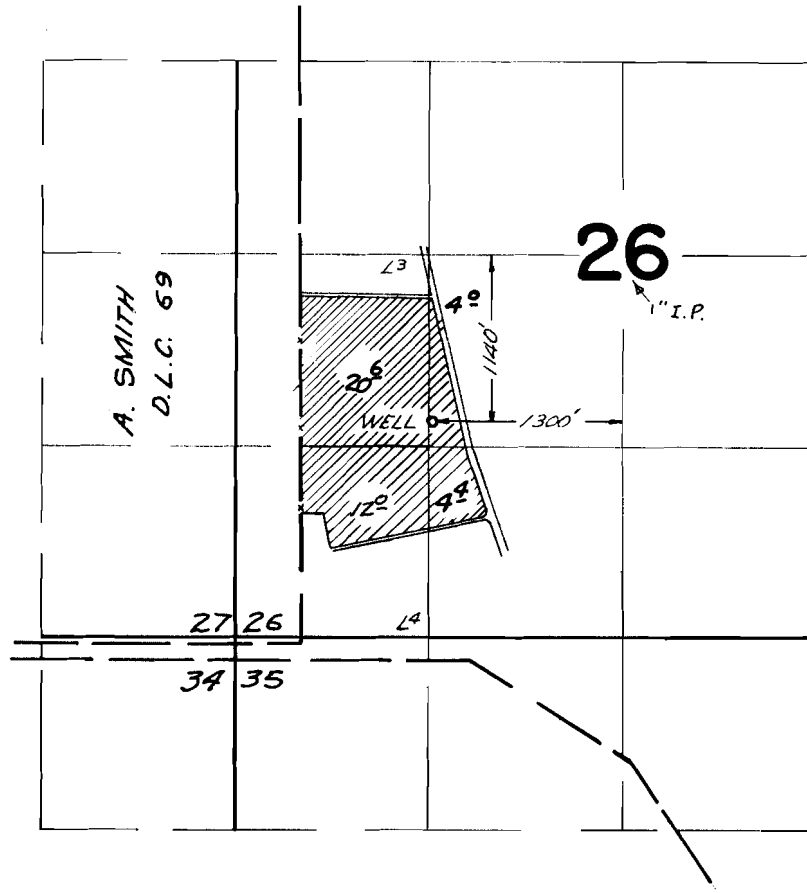

## FINAL PROOF SURVEY UNDER

Application No. G-2070 Permit No. G-1959  
IN NAME OF

NICOLI W. HOLOBOFF

Surveyed Sept. 7, 1966, by V. GARNER