T.6 S.R.2 W.W.M.

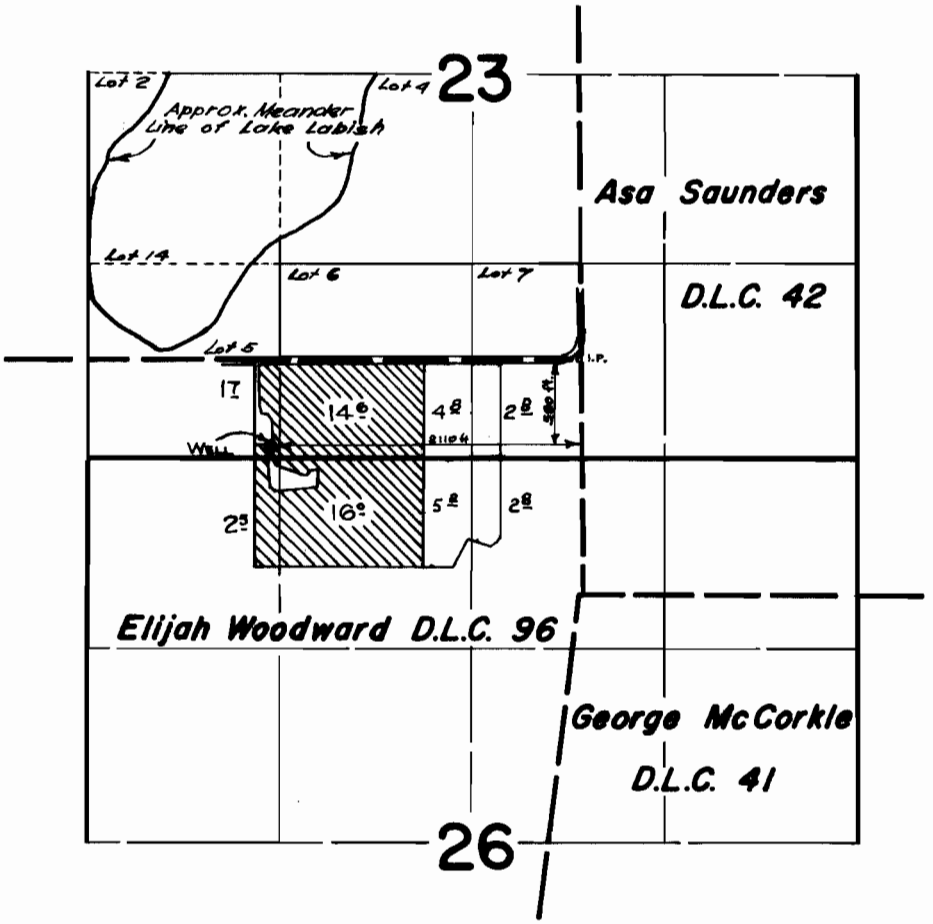

FINAL PROOF SURVEY
UNDER

Application No. G-2300 Permit No. G-2120
IN NAME OF

BRUCE L. DICKMAN

Surveyed June 4 1965, by R. H. Jackson

1965-C