


T.9S.R.4W.W.M.

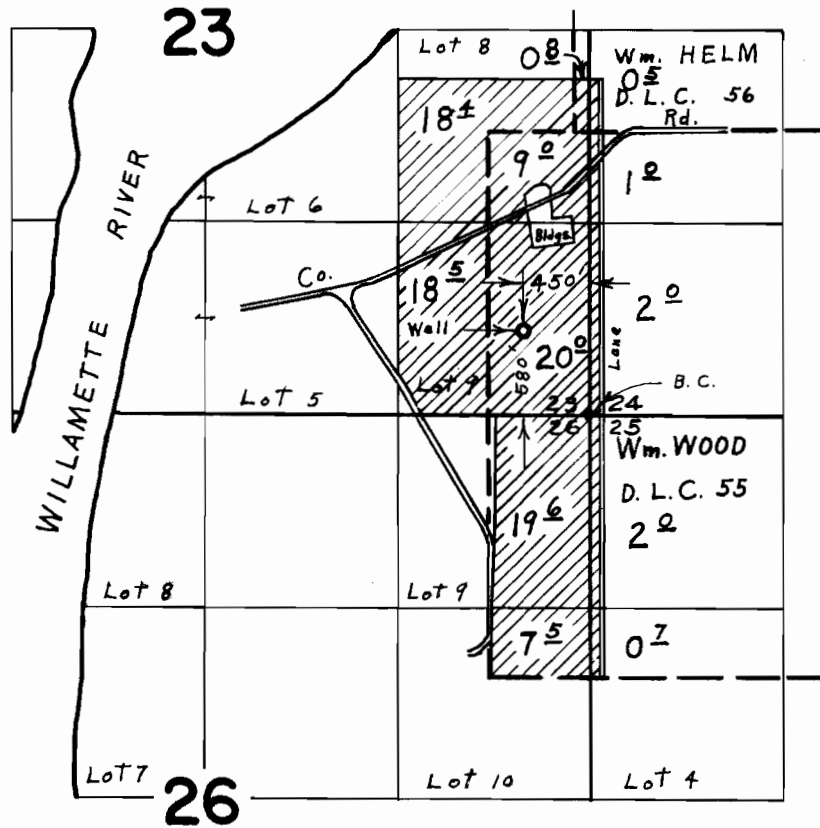

FINAL PROOF SURVEY UNDER

Application No. G-2406 Permit No. G-2215
IN NAME OF

GAYLE W. GILMOUR

Surveyed Sept. 8, 1966, by L. E. Gould