


# T. 5 S. R. 2 W. W.M.

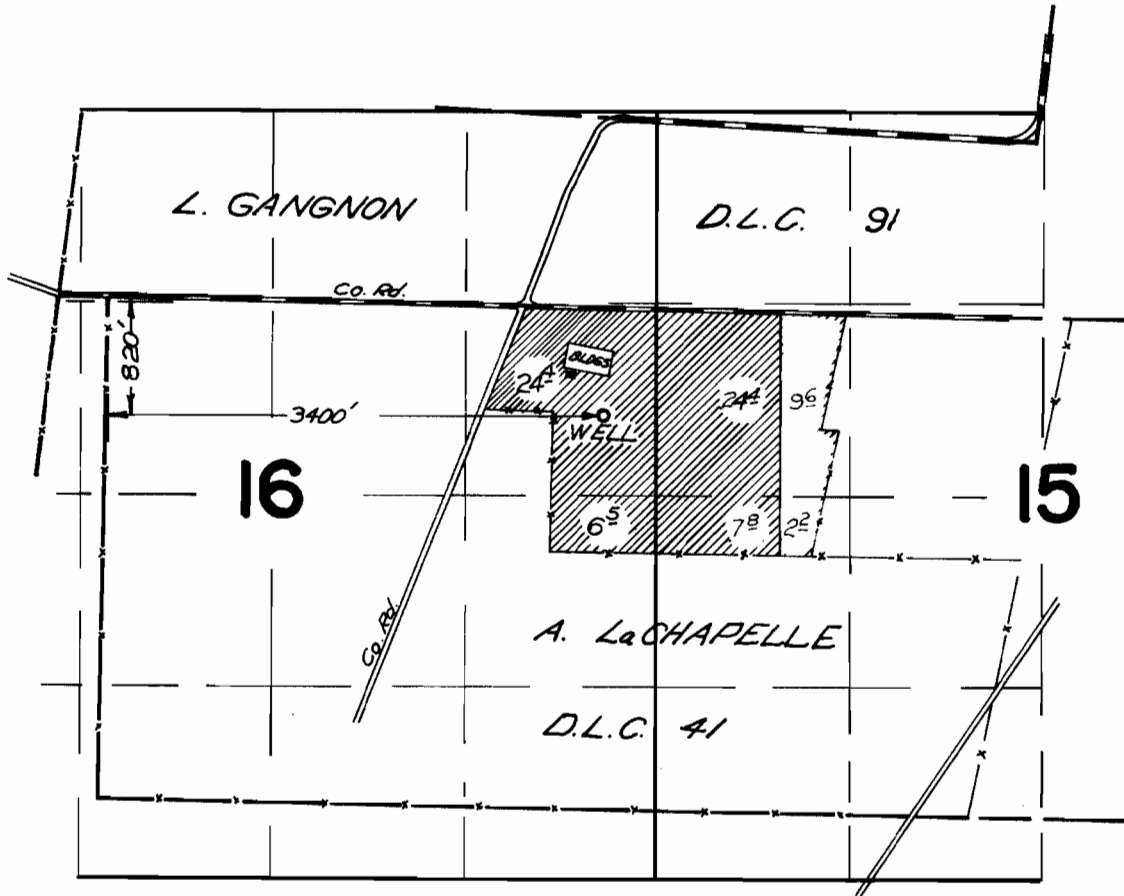

## FINAL PROOF SURVEY UNDER

Application No. G-2601. Permit No. G-2406.  
IN NAME OF

*DONALD K. RAY and THOMAS W. RAY*

Surveyed Sept. 27 1966, by V. GARNER.....