


T.5 S. R.2 W. W.M.

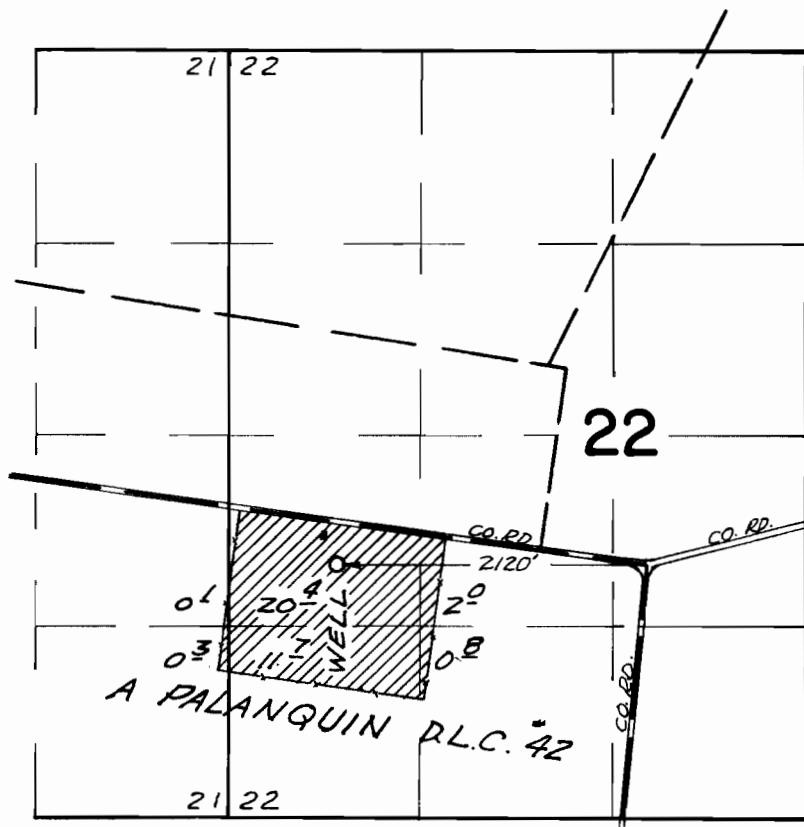

FINAL PROOF SURVEY
UNDER

Application No. G-2724 Permit No. G-2589
IN NAME OF

JACOB and FLORENCE DeSHAZER

Surveyed Sept 28 1966, by V. GARNER