


T.8S.R.4W.W.M.

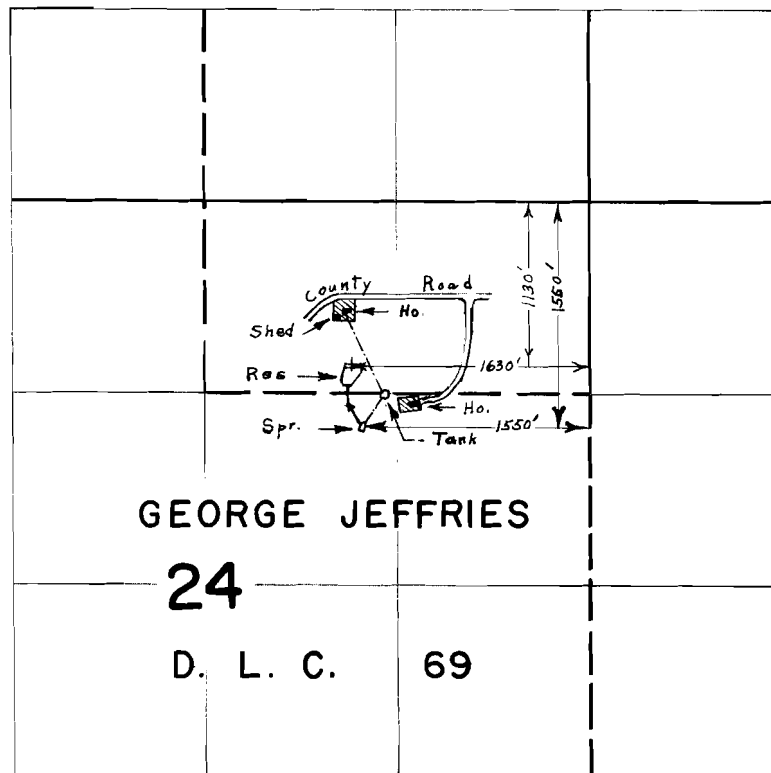

FINAL PROOF SURVEY
UNDER

R-37028 R-2661
Application No. 37.029 Permit No. 27562.
IN NAME OF

DAVID L. & LORETTA M. WARNER

Surveyed Sept. 8, 1966, by R. E. Gould