


Township 39   C  , Range 4 E.

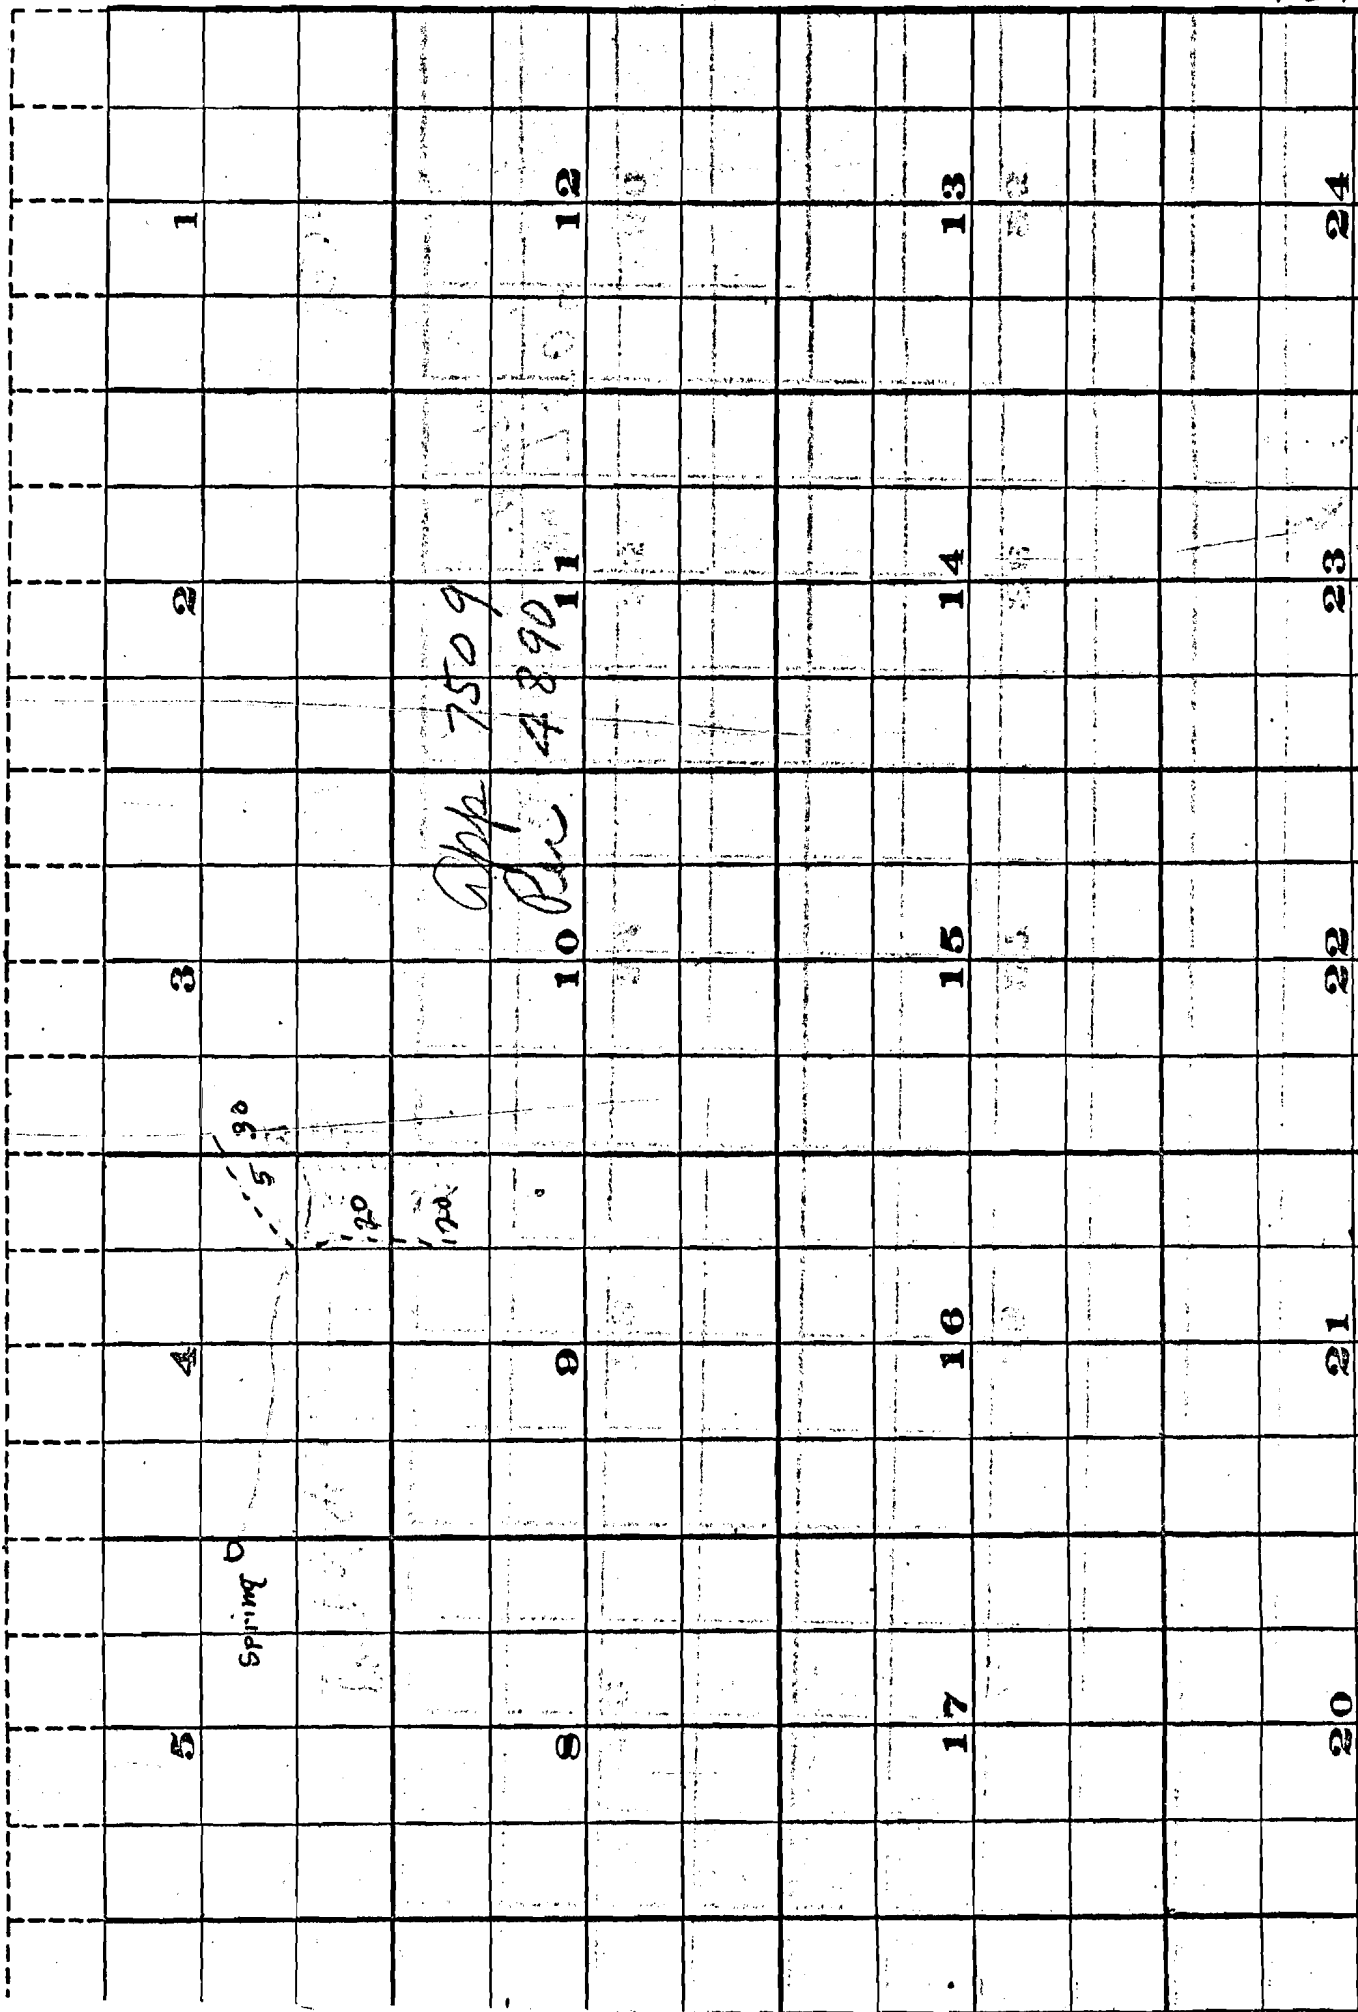

4890

3463