


# T.4S.R.2W.W.M.

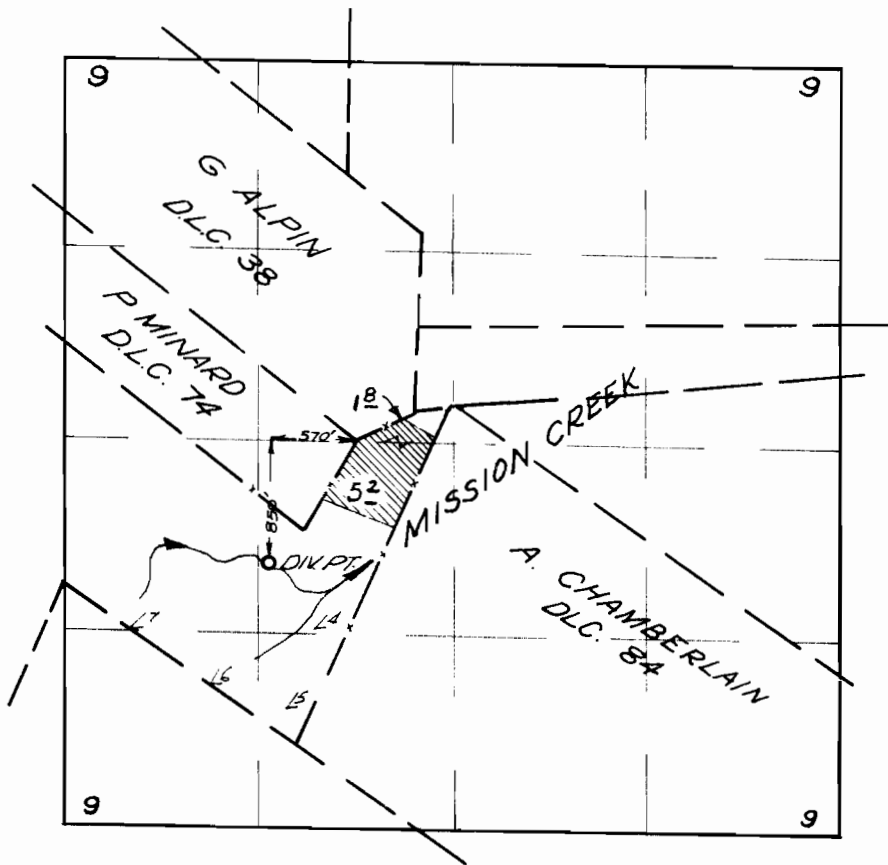

## FINAL PROOF SURVEY UNDER

Application No. 37116 Permit No. 27623  
IN NAME OF

*VERN V. BROWN*

Surveyed *Sept. 8 1966*, by *V. GARNER*.....