


# T. 6 S. R. 1 E. W. M.

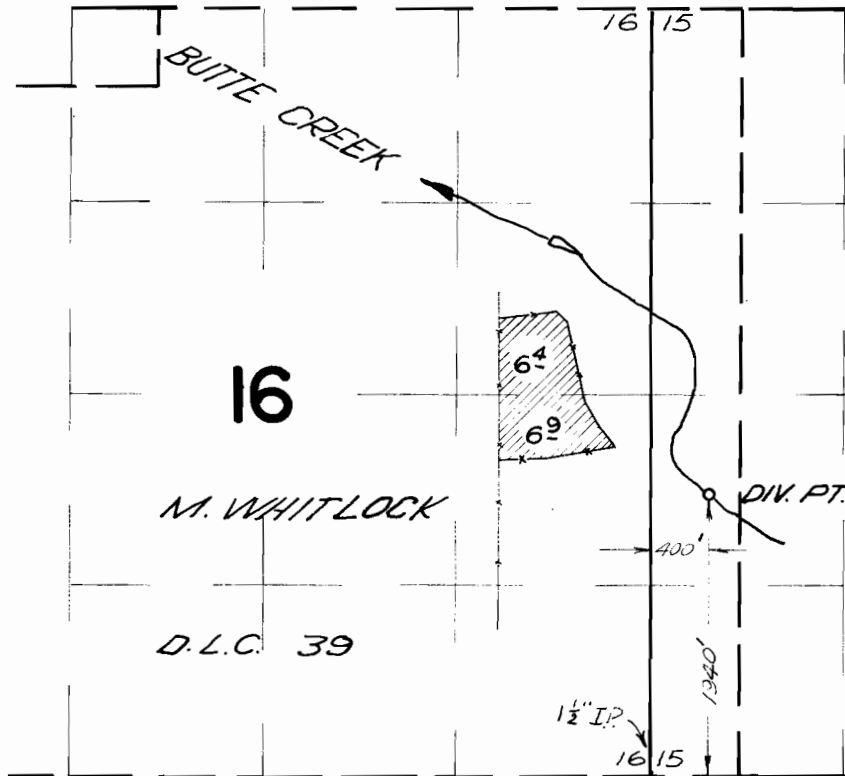

## FINAL PROOF SURVEY UNDER

Application No. 39738 Permit No. 29559  
IN NAME OF

*JAMES H. NICHOLSON*

Surveyed Aug 18, 1966, by V. GARNER