


T.2&3S. R.39E. W.M.

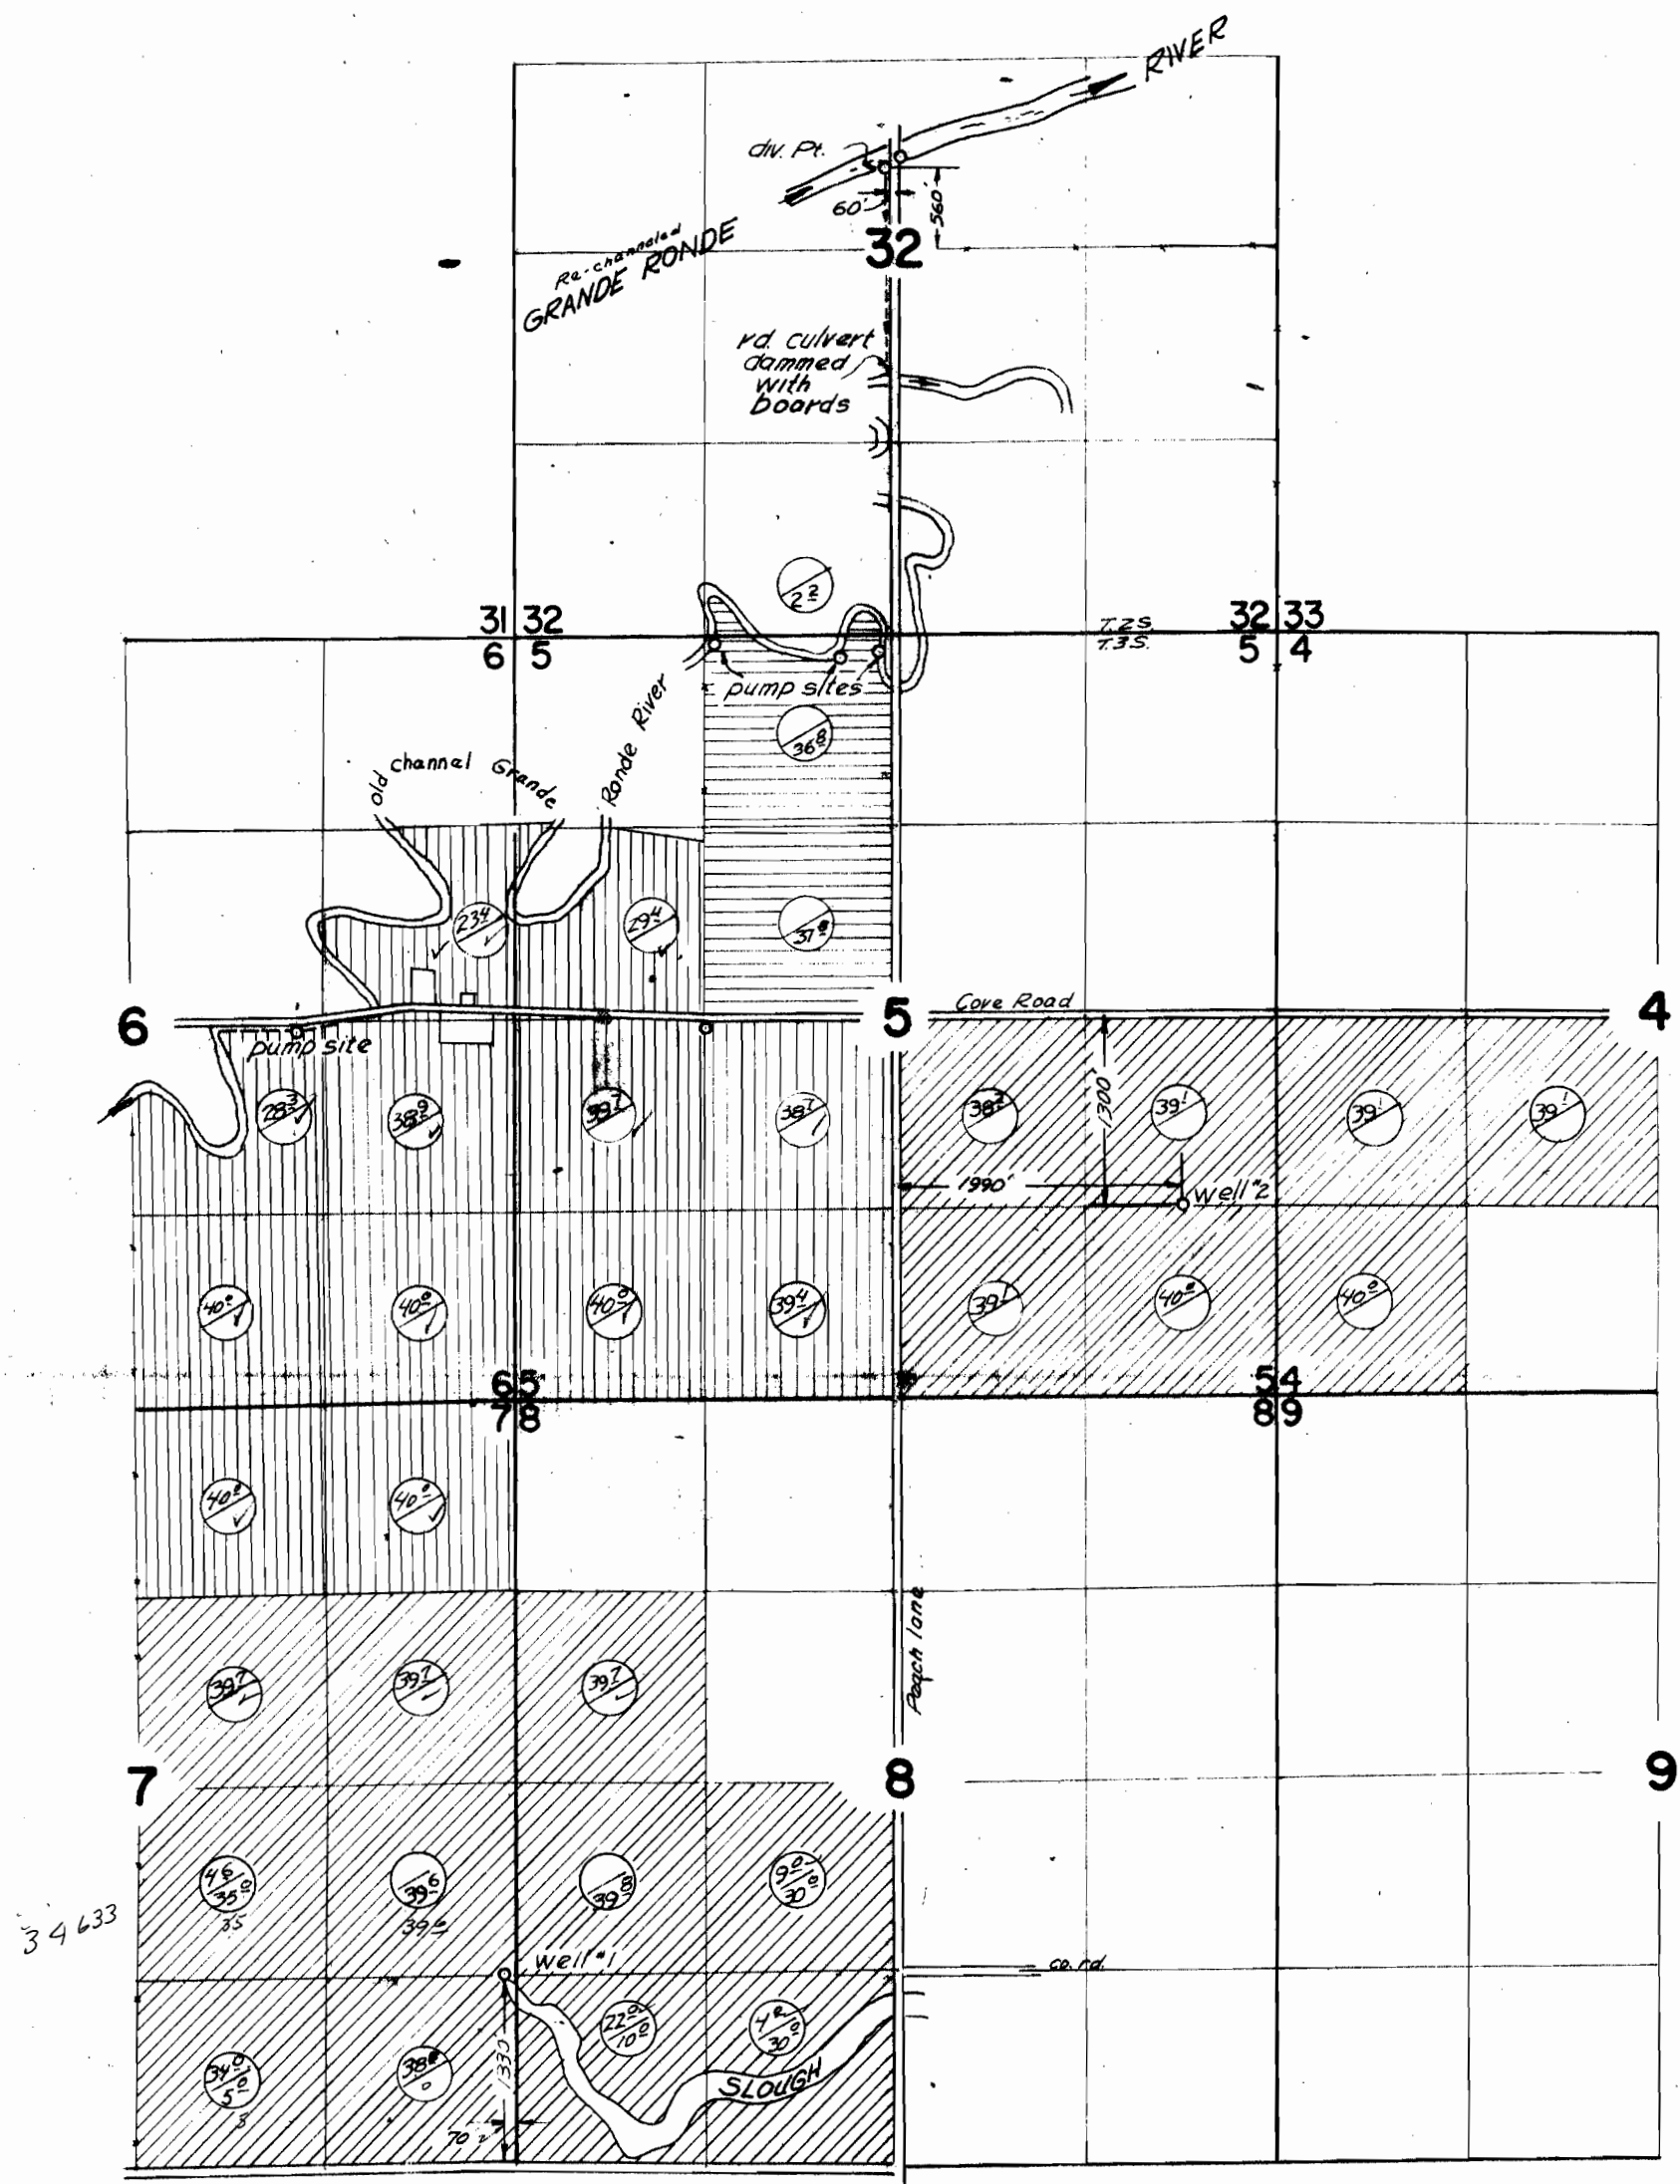

**FINAL PROOF SURVEY**  
UNDER

Application Nos. G-2715 G-2798 Permit Nos. G-2520 G-2618  
IN NAME OF

**WEISHAAR BROTHERS**

Application No. 37848 Permit No. 28799  
IN NAME OF

**STANLEY and MAURICE WEISHAAR**

Application No. 38290 Permit No. 28804  
IN NAME OF

**STANLEY WEISHAAR**

Surveyed Aug. 26, 28, 1967 by V. Garner

