


# T.4S.R.39E.W.M.

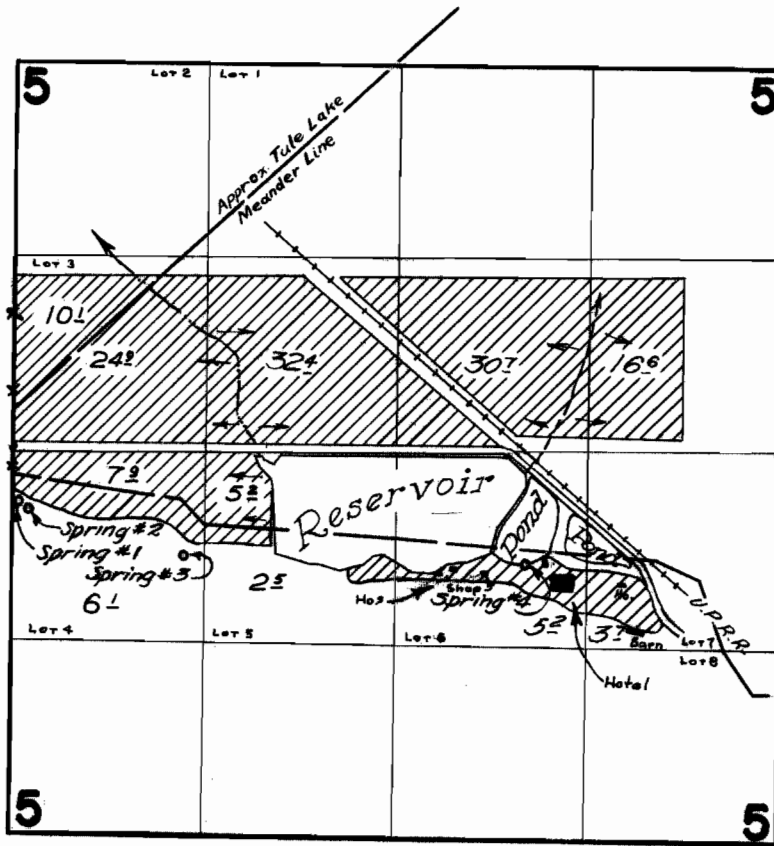

## FINAL PROOF SURVEY UNDER

R-37102                      R-2713  
 Application No. 34967... Permit No. 27696...  
 IN NAME OF

A. J. & FERN L. ROTH

Surveyed Sept. 30, 1963, by C. R. Baker

RT