


T.2&3S. R.39E. W.M.

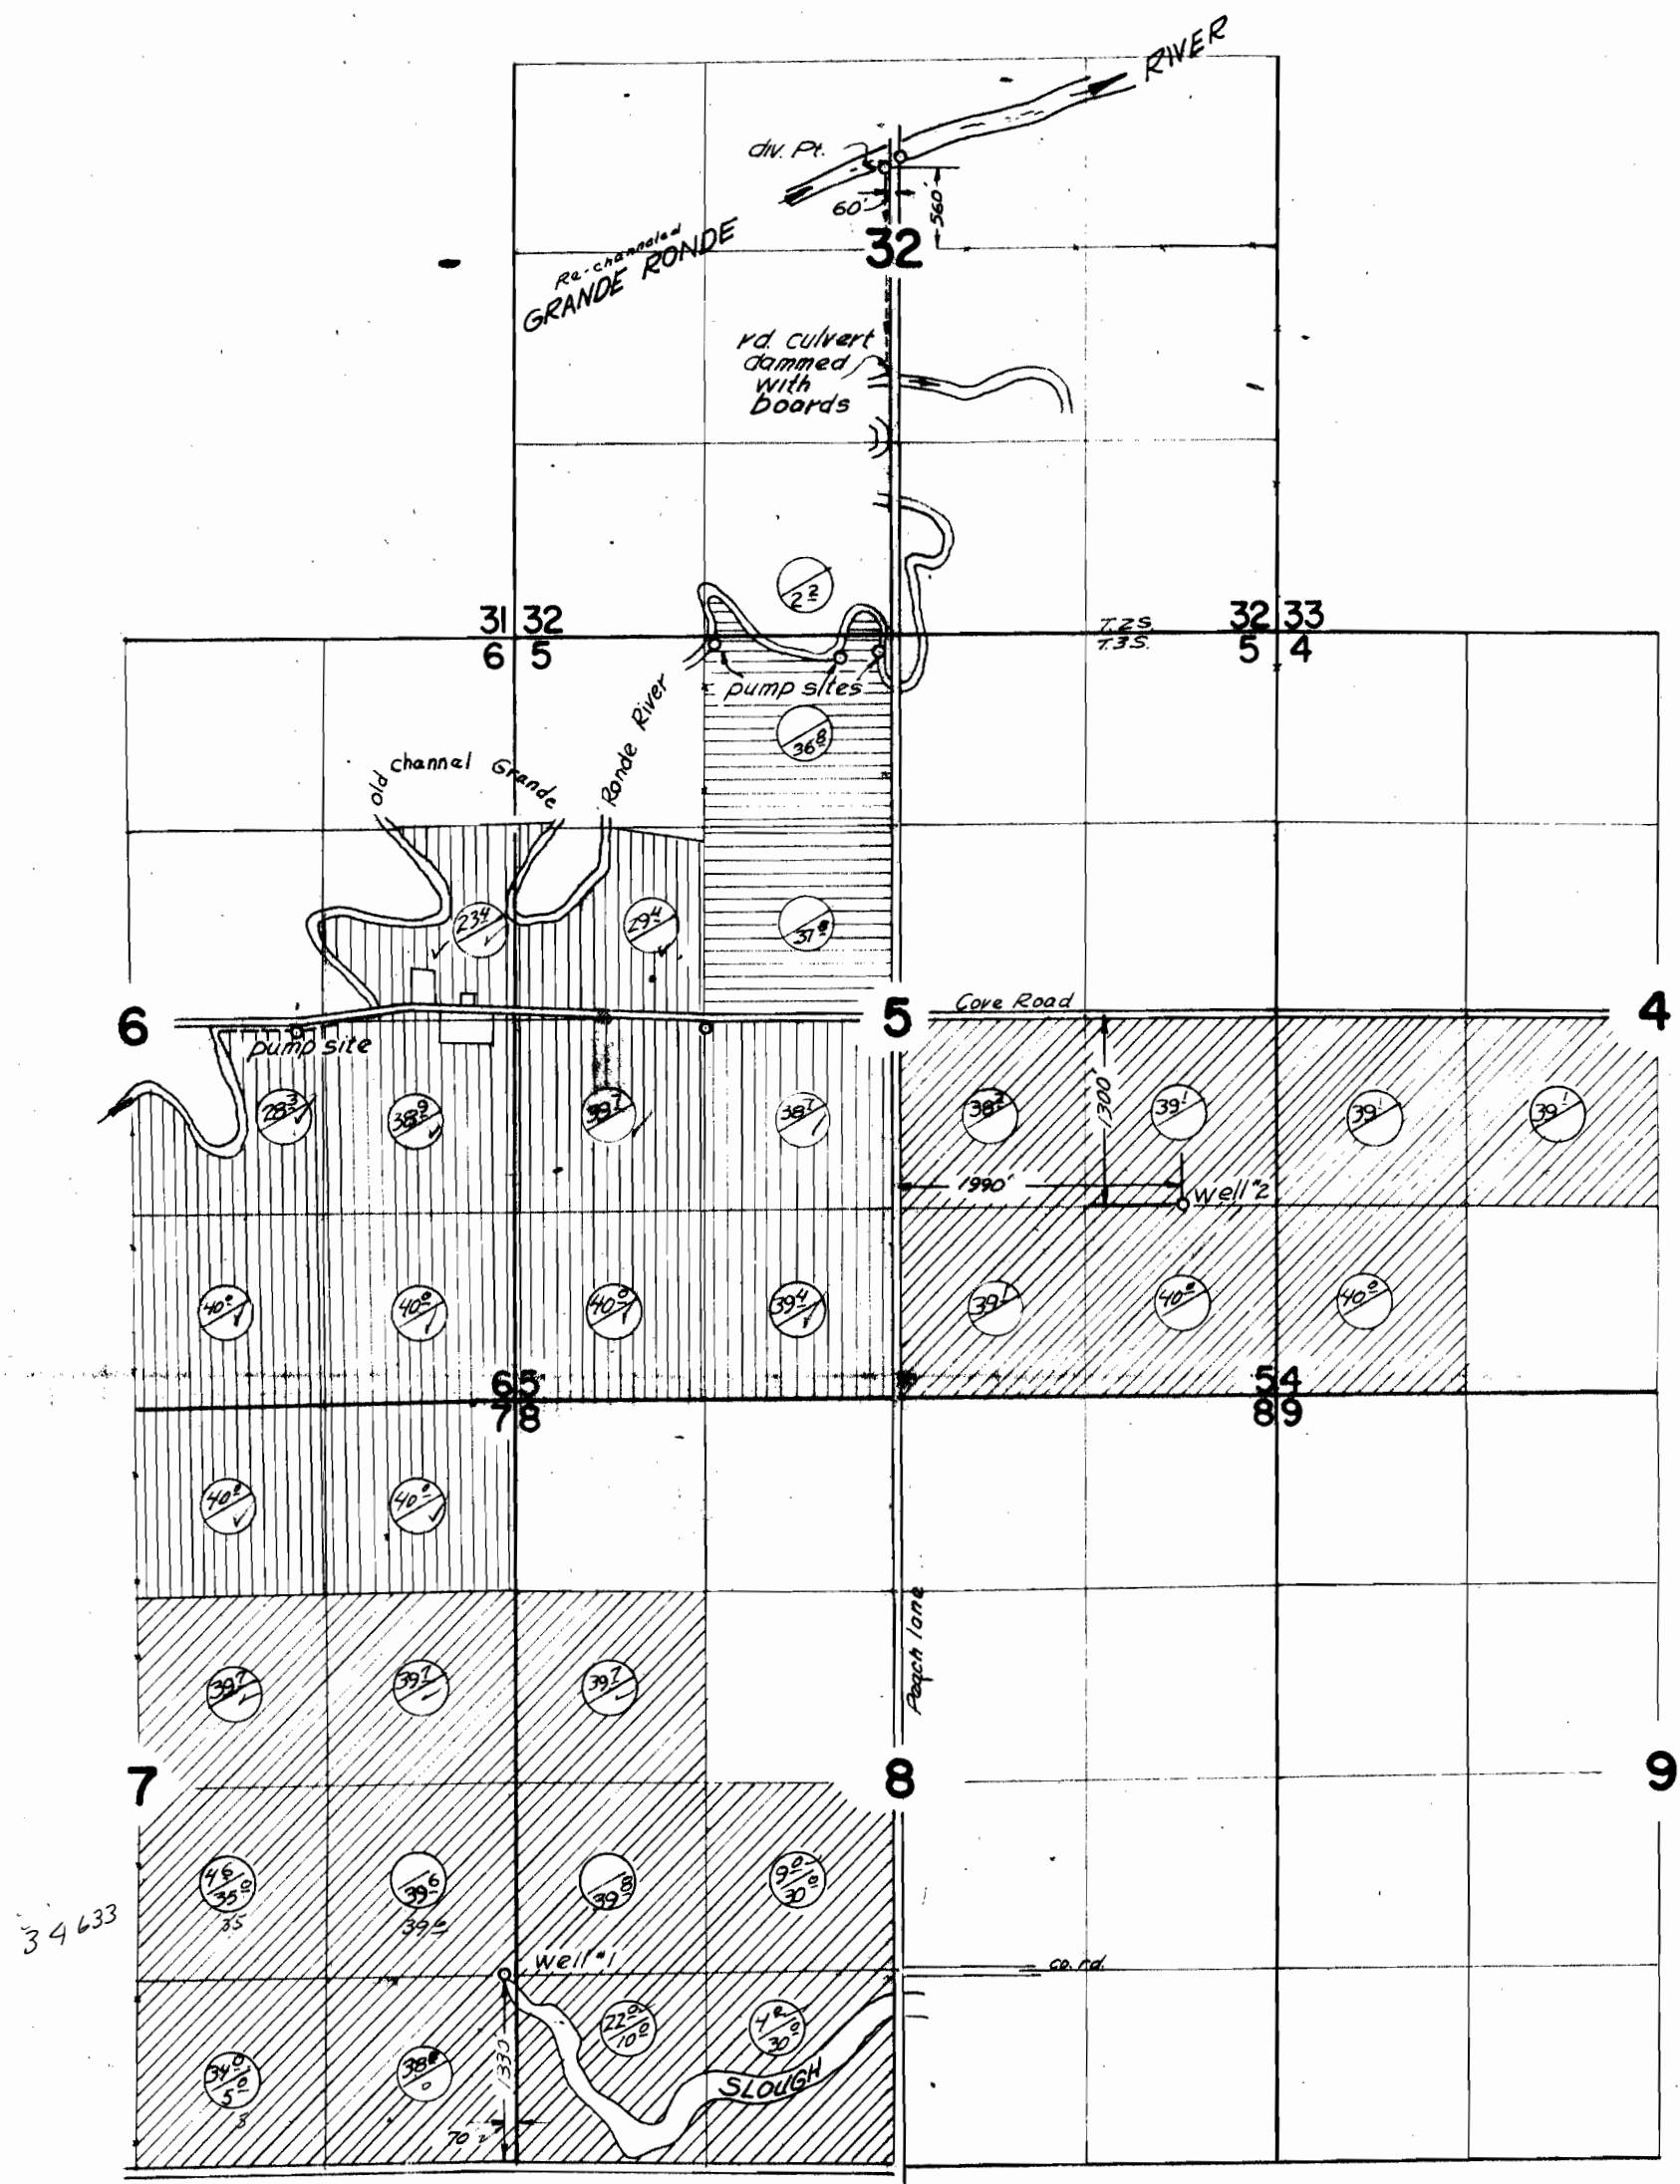

FINAL PROOF SURVEY
UNDER

G-2715 Application Nos. G-2798 Permit Nos. G-2520 G-2618
IN NAME OF

WEISHAAR BROTHERS





Application No. 37848 Permit No. 28799
IN NAME OF

STANLEY and MAURICE WEISHAAR

Application No. 38290 Permit No. 28804
IN NAME OF

STANLEY WEISHAAR

Surveyed Aug. 26, 28, 1967 by V. Garner

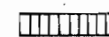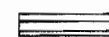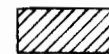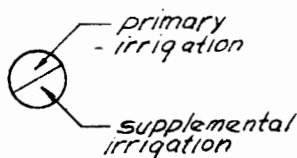

34633