


T.4 S. R.4 W. W.M.

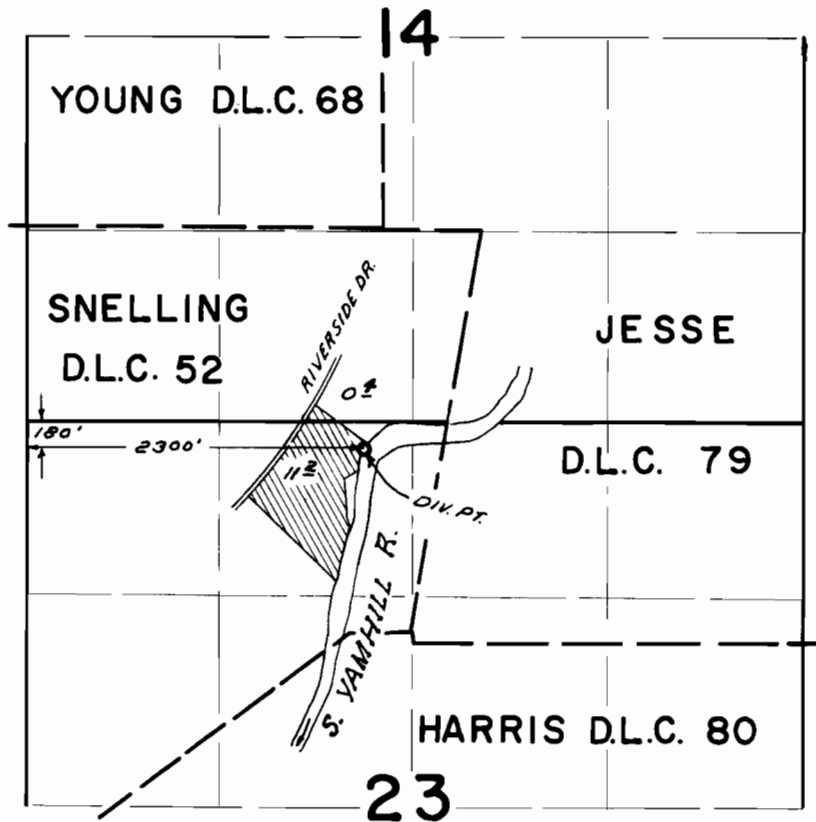

**FINAL PROOF SURVEY**  
UNDER

Application No. 37494 Permit No. 27946  
IN NAME OF

WILLIAM N. & JUNE L. O'NEIL

Surveyed NOV. 4, 1965, by L. COLEBANK