


T. 7 S. R. 38 & 39 E. W.M.

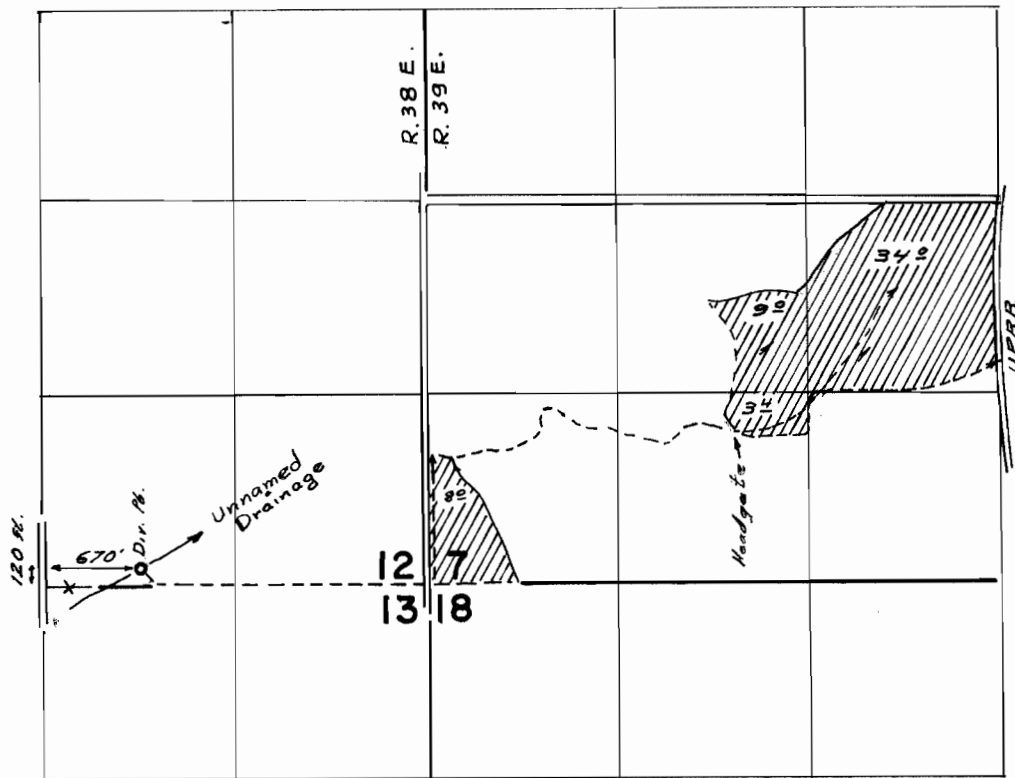

FINAL PROOF SURVEY UNDER

Application No. 37761 Permit No. 28276
IN NAME OF

WILLIAM O. CHRISTENSEN

Surveyed Aug. 6 1966, by W. J. Ruppert