


T.8S. R.39E. W.M.

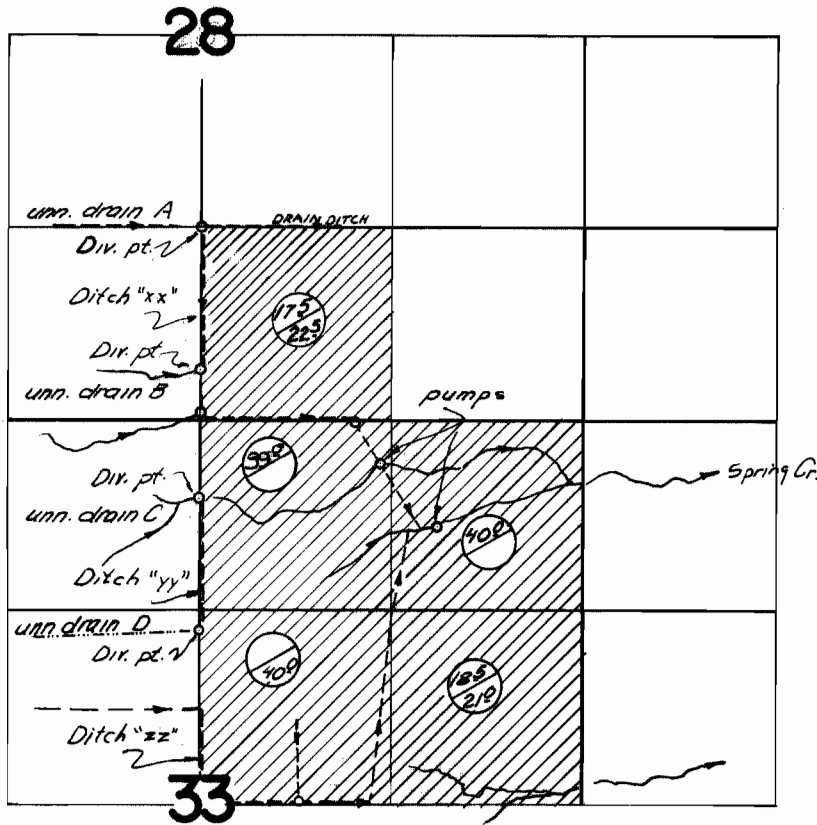

Div. pts. located 1320 ft. N. & 5 ft. E.; 350 ft. N. & 5 ft. E.; 540 ft. S. & 5 ft. E.; 1440 ft. S. & 5 ft. E. all from the N. & E. cor. Sec. 33. Collection ditches located between points 1320 ft. N. & 5 ft. E. & 350 ft. N. & 5 ft. E.; 540 ft. S. & 5 ft. E. & 1450 ft. S. & 5 ft. E.; 1980 ft. S. & 5 ft. E. & 2635 ft. S. & 1160 ft. E. all from the N. & E. cor. Sec. 33

/ Primary
/ Suppl

FINAL PROOF SURVEY UNDER

Application No. 38150 Permit No. 29016
IN NAME OF

NORMAN BUTLER

Surveyed Oct. 25, 26 1962., by V. Garner