T.25S.R.13&14W.W.M.

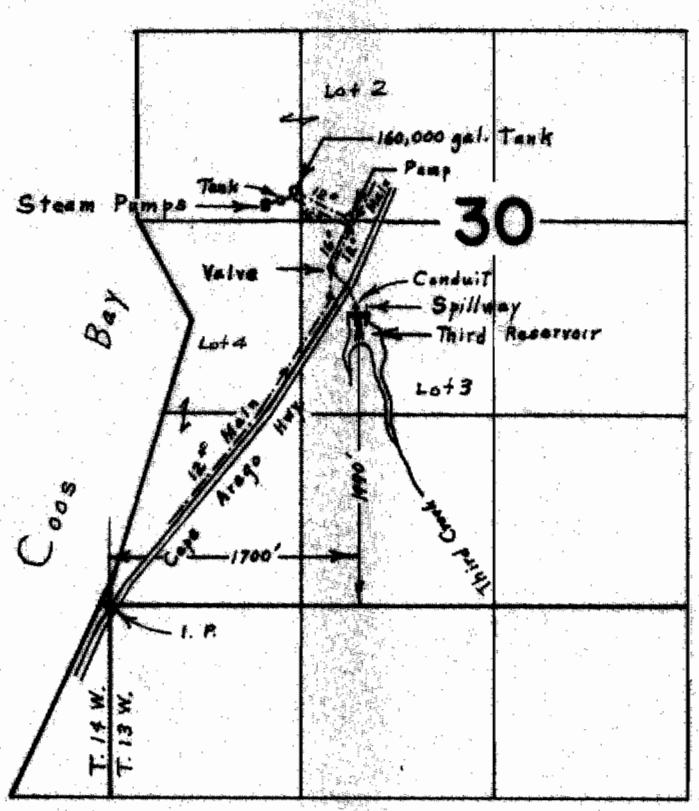

FINAL PROOF SURVEY
UNDER

R-36119 R-2651
Application No. 37037 Permit No. 27518
IN NAME OF

COOS HEAD TIMBER CO.

Surveyed Sept 19 1966, by L. E. Gould

1966-W