


T.18S. R.4W. W.M.

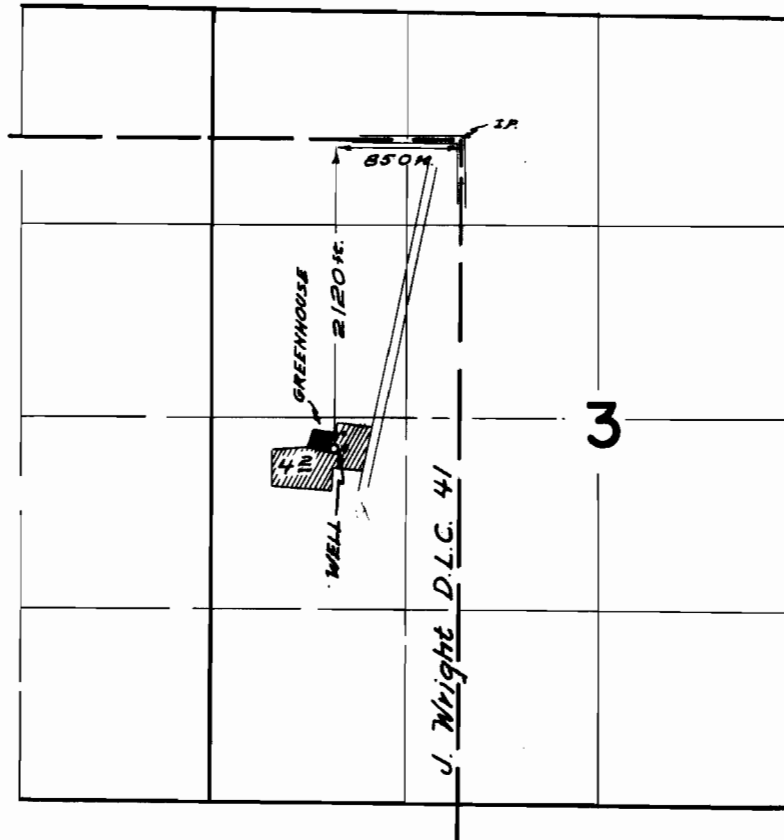

FINAL PROOF SURVEY UNDER

Application No. G-2148 Permit No. G-1981
IN NAME OF

GEORGE DALE WATSON

Surveyed May 16, 1966, by W.J. Ruppert