


T. 16 S. R. 4 W. W.M.

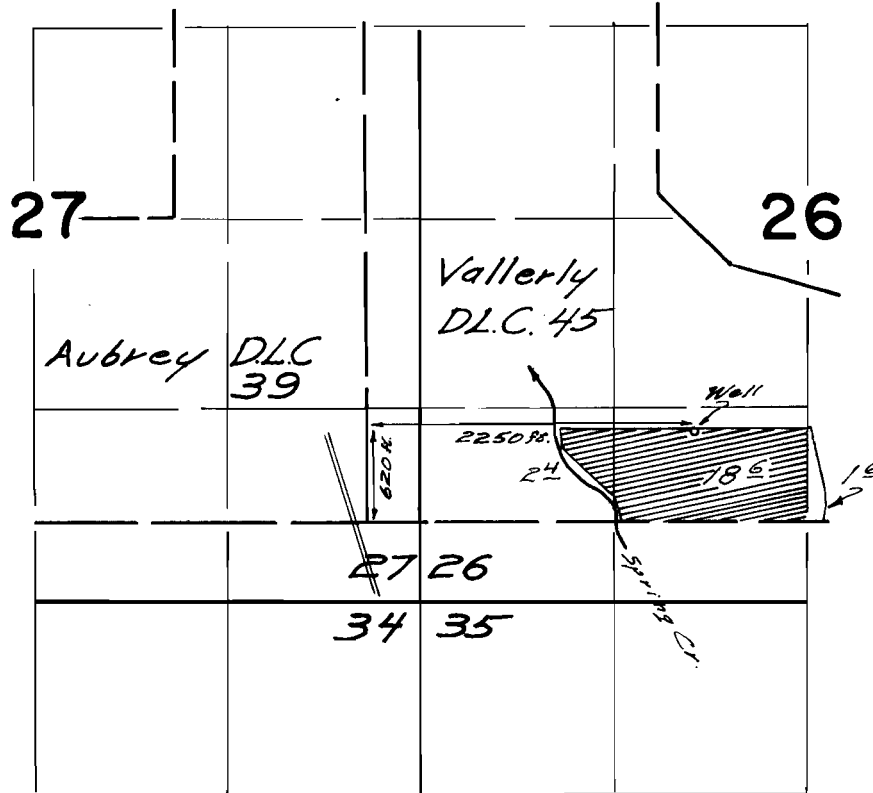

**FINAL PROOF SURVEY**  
UNDER

Application No. ~~G-2853~~ Permit No. ~~G-2656~~  
IN NAME OF

*Clarence & Hazel Bond*

Surveyed *May 18* 1966, by *W. d. Ruppert*