


T.18S.R.5W.W.M.

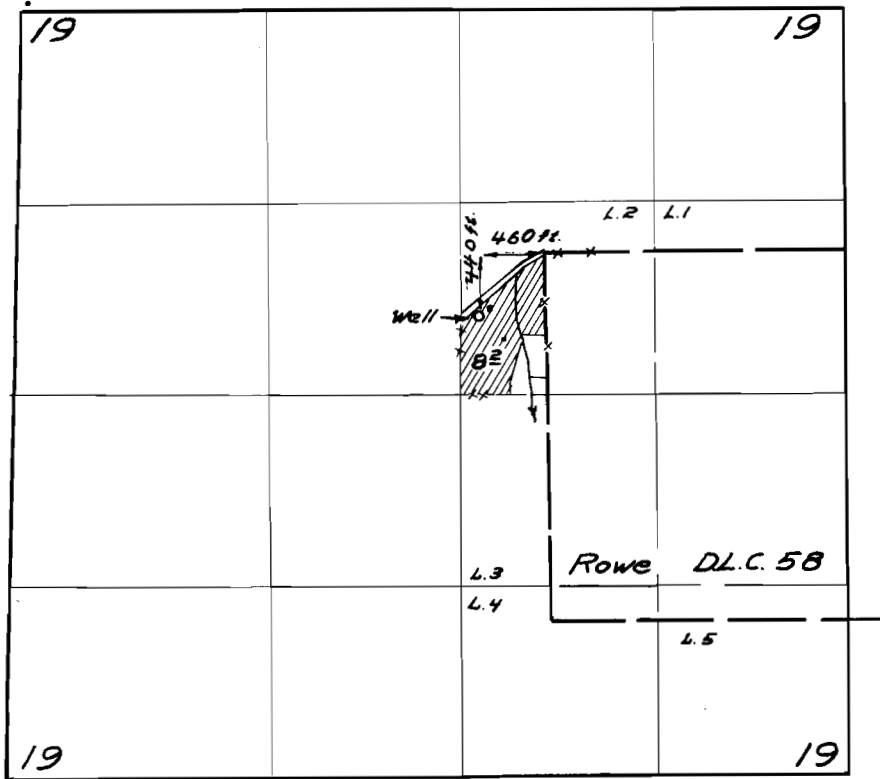

**FINAL PROOF SURVEY**  
UNDER

Application No. G-2942 Permit No. G-2691  
IN NAME OF

JAMES B. COEN

Surveyed May 20 1966, by W.J. Ruppert