


T.16S. R.4.W.W.M.

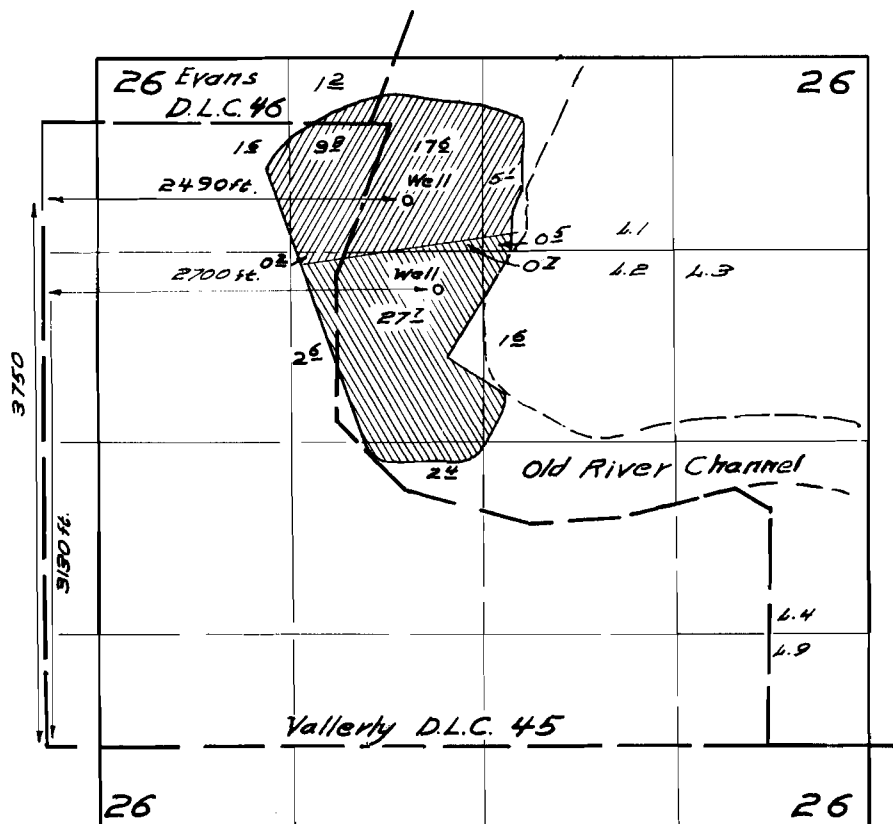

FINAL PROOF SURVEY UNDER

Application No. G-3030 Permit No. G-2818
IN NAME OF

ORVILLE L. CHAPMAN

Surveyed May 17 1966, by W.J. Ruppert.