


T. 16S. R. 4W. W.M.

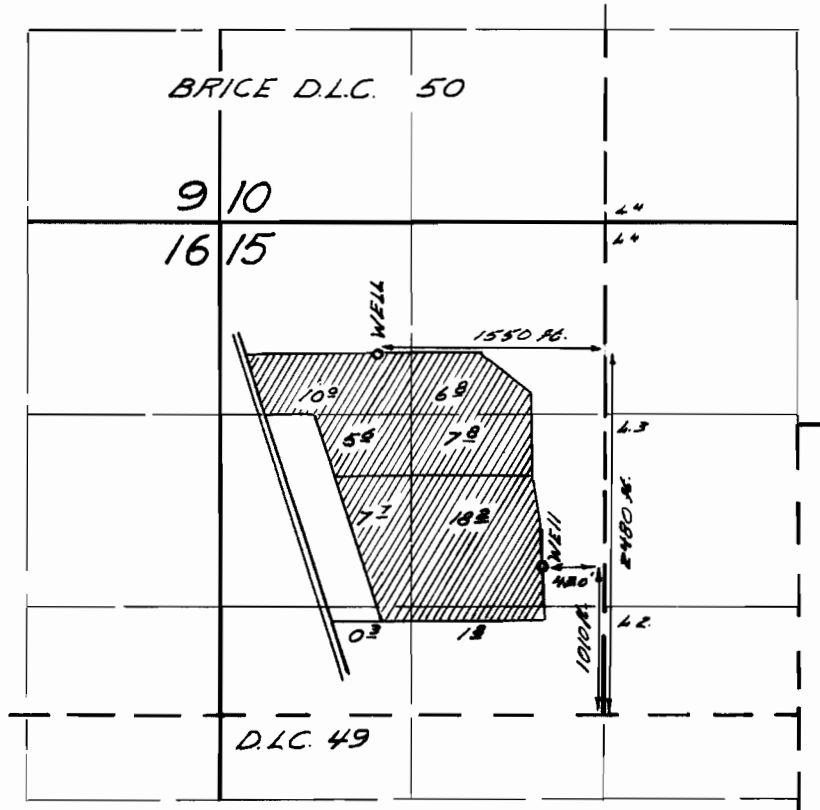

FINAL PROOF SURVEY UNDER

Application No. G-3126 Permit No. G-2918
IN NAME OF

S. Bert Simmons

Surveyed May 17, 1966, by W.J. Ruppert