


T.17S. R.4W. W.M.

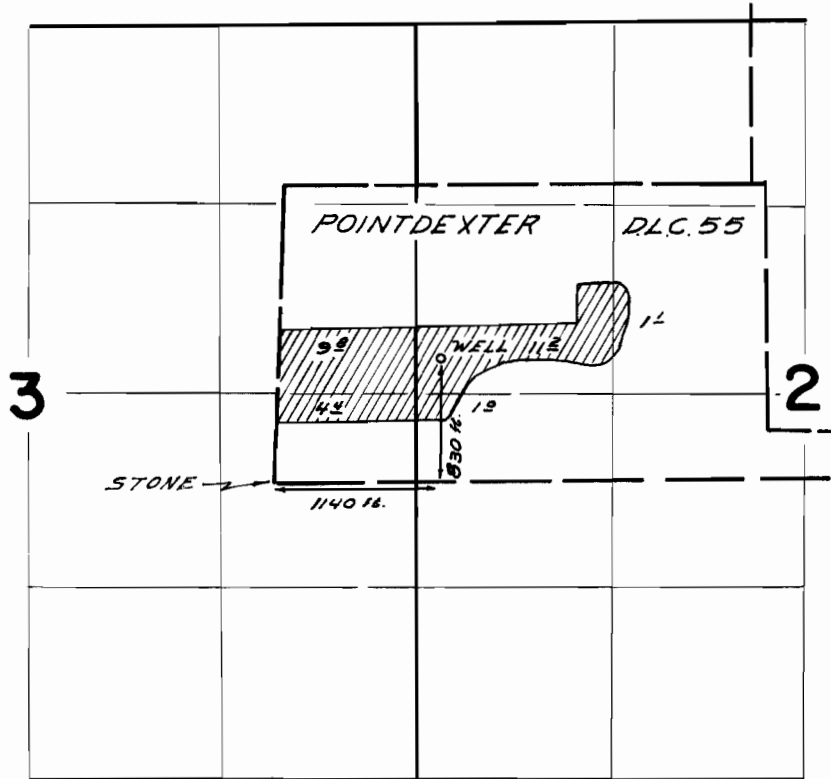

FINAL PROOF SURVEY
UNDER

Application No. G-3170... Permit No. G-2981
IN NAME OF

Arthur A. Guthrie

Surveyed MAY 19 1966, by W.J. Ruppert...