




T.19S. R.3W. W.M.

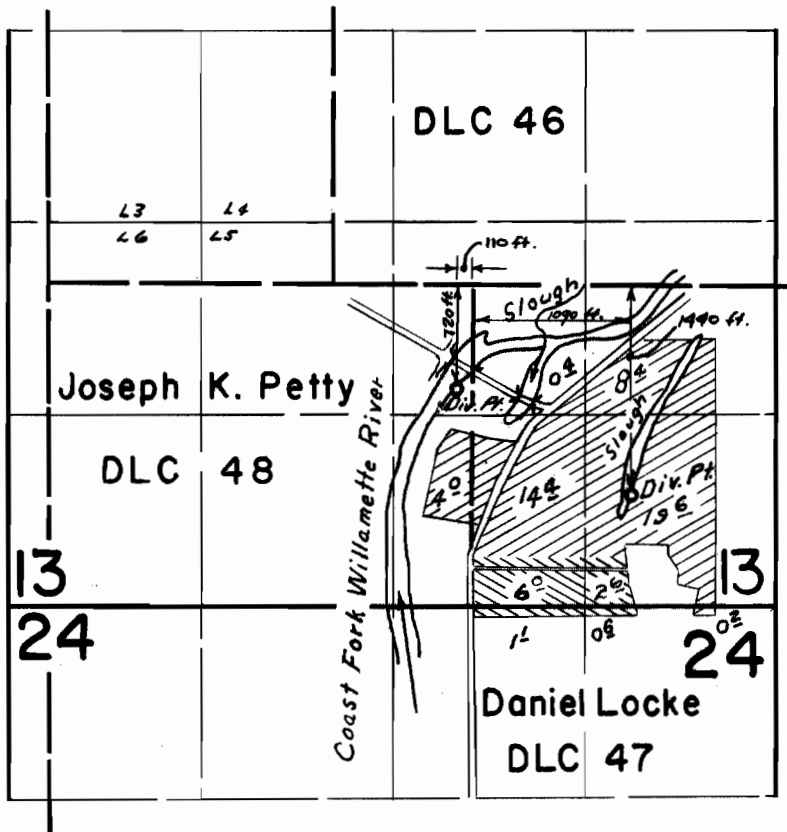

-  East Slough
-  Coast Fork Willamette River

**FINAL PROOF SURVEY**  
UNDER

Application No. 33968... Permit No. 26923  
IN NAME OF  
**EARL S. PETTY**

Surveyed June 29, 1964, by R. Jackson