


T.17S. R.5W.W.M.

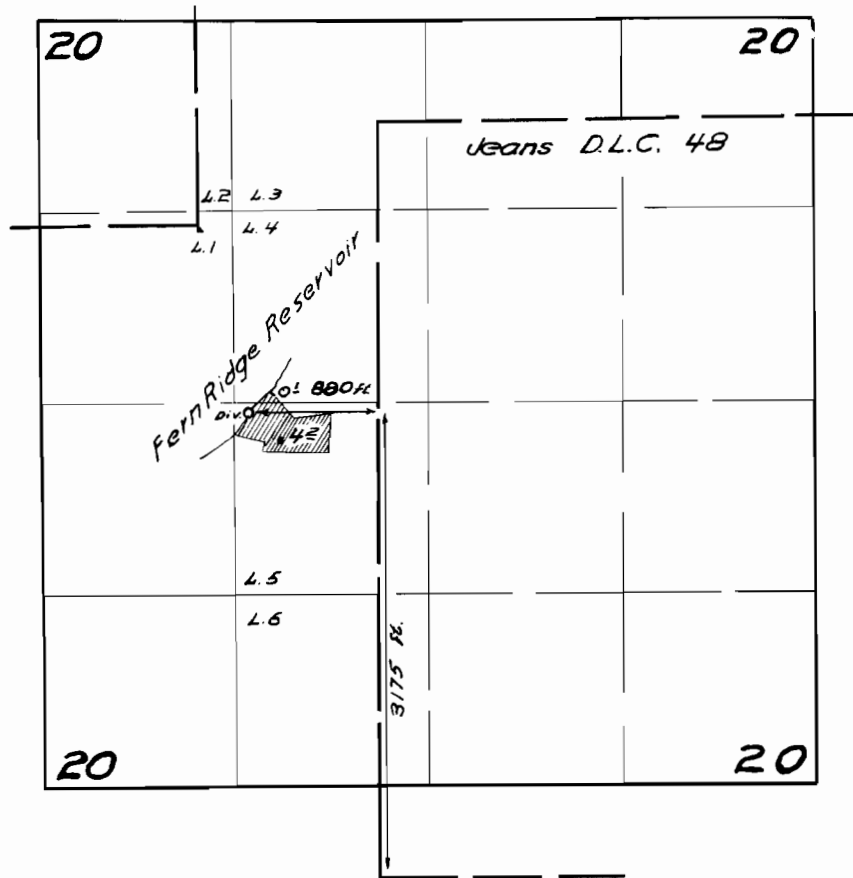

FINAL PROOF SURVEY UNDER

Application No. 34283 Permit No. 27003
IN NAME OF

ELMER VICTOR & JACQUELINE LUNDEEN

Surveyed May 19 1966, by W. J. Ruppert