


T.17 S.R.2 W. W.M.

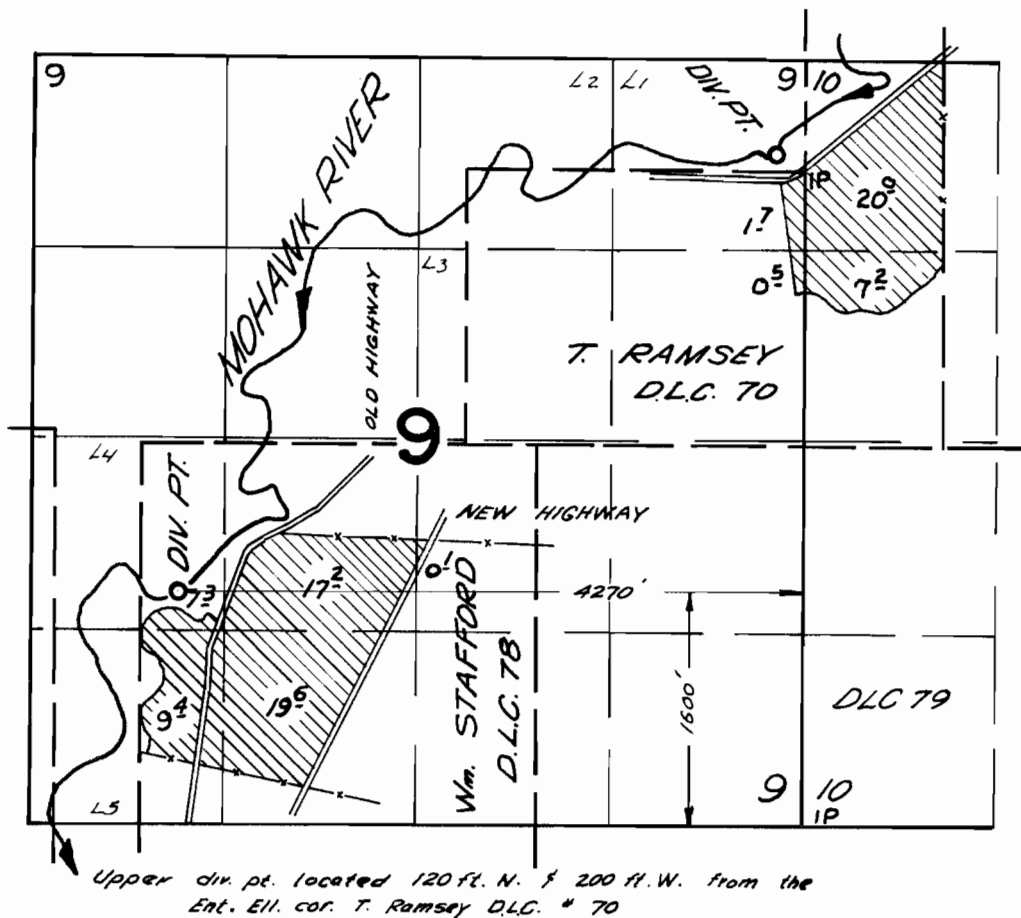

FINAL PROOF SURVEY UNDER

Application No. 37275 Permit No. 27770
IN NAME OF

PETER HANSEN

Surveyed May 6-11, 1966, by V. GARNER